


Section 28 Township 32 Range 39-W

Well No. #1 Drew "C"

Company Stanolind

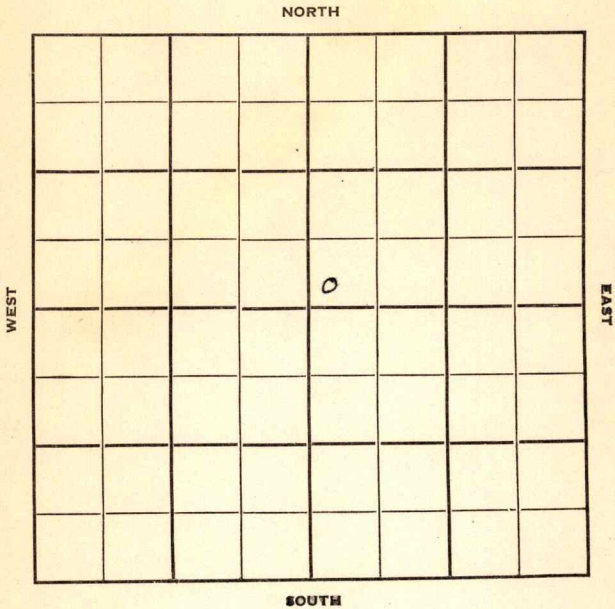

Morton

KANSAS

Sec. 28 Twp. 32 R. 39W

Well No. #1 Drew "C" Farm

Stanolind

Company

Contractor

Hugoton Pool


Ft. from N. Line

150' Ft. from S. Line

Ft. from E. Line

150' Ft. from W. Line

SW NE

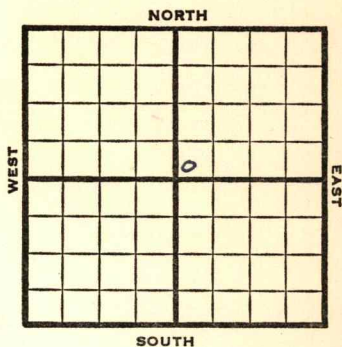

1950

Elev 3170

REPORT

9/20 Location

10/18 10" @ 559

7" @ 2566

TD 2608

Krider 2386

Towanda 2509

Ft. Riley 2566

204/2386-2410, 96/2454-70

138/2513-36


21500 A

Comp 22,309,000 gas

Completed

COMPLETED

J. E. TYRA

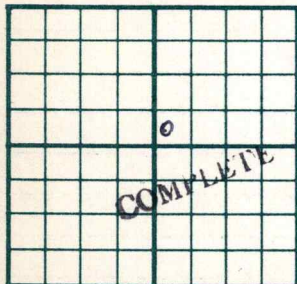County Morton State KansasSec. 28 (Blk. 32 (Sur. 39W (Twp. Map No.Operator StanolindWell No. 1 Farm Drew "C"Elev. 3170 Location SW NE150 Ft. From S Line NE150 Ft. From W Line Quarter

1st. Report

Completion OCT 18 1950Remarks Hugoton Pool

Spudding Date

Drlg. Data Gas well TD 260810" @ 559 7" @ 2566 TD 2608Krider 2386 Towanda 2509 Ft. Riley 2566204/ 2386-2410 96/ 2454-70 138/ 2513-3621500 A Comp. 22,309,000 gas

J. E. TVRA