

Section 34 Township 32 Range 4 WWell No. # 1 PearceCompany E. H. Adair

NORTH

							0

SOUTH

WEST

EAST

Sumner

KANSAS

SEC.	TWP.	R.
34	32	4 W ✓

WELL NO.

1 Pearce

FARM

COMPANY

E. H. Adair

CONTRACTOR

Adair

Wildcat


_____ Ft. from N. Line

330 _____ Ft. from S. Line

330 _____ Ft. from E. Line

_____ Ft. from W. Line

SE SE SE

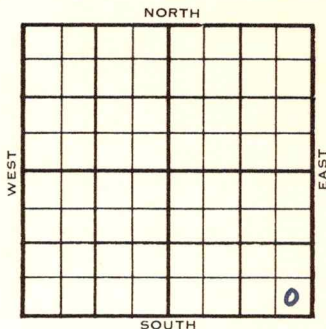

1953

ELEVATION

1228'

REPORT

11/18

Location

12/9

8" @ 197'

12/16

Spud 11-28-53

D & A

TD 4317'

8" @ 197'

Lans 3317',

DST 3432'-43' opn 1 hr, rec 330' gcm

120' wtr. 1400# B KC 3589', Oswego

3643', Cherokee 3812', Miss 3970',

Simp 4301'

DST 4299'-4317' opn 1½ hr, rec 184'

wtr 1560#

D & A

ABANDONED

J. G. McGEHEE