


KANSAS

Section 35 Township 32 Range 4WWell No. #1 BirkholzCompany Aladdin Pet.

KANSAS

Sumner

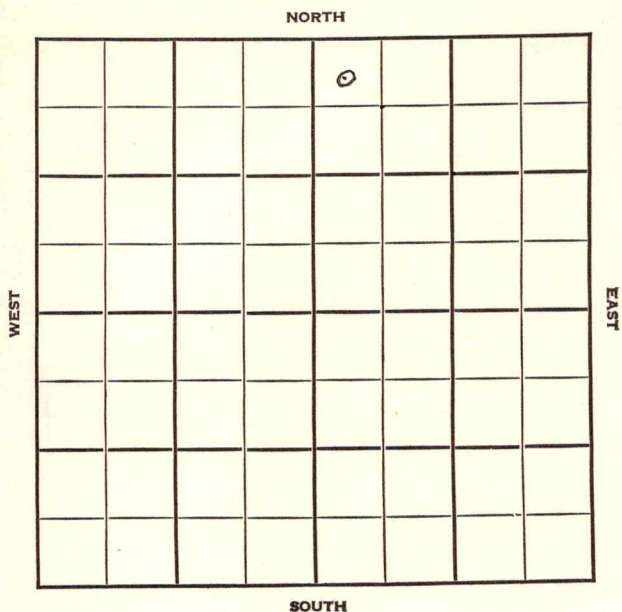

Sec. 35 Twp. 32 R. 4W

Well No. #1 Birkholz Farm

Aladdin Pet. Company

Wildcat


330 Ft. from N. Line

 Ft. from S. Line

 Ft. from E. Line

330 Ft. from W. Line

NW NE

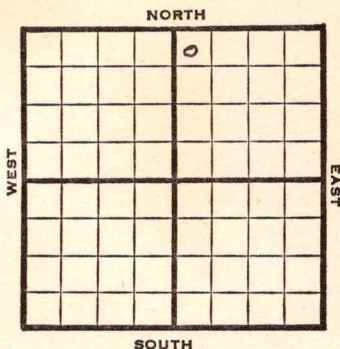

1948

Elev. 1218' REPORT

1/28 Location

2/4 8" @ 552'
Drlg. 1392'

4324
1218

3106

2/11 **KC 3282'**
Drlg. 3540'

2/18 **Mississippi 3927'**
Simpson 4324'
Drlg 4350'

2/25 **Arb. 4433'**
TD 4510'
Abd.

ABANDONED

Map No. _____ Sec. 35 Twp. 32 R. 4W

Well No. 1 Birkholz

Aladdin Pet. Company

FIRST REPORT Contractor

NW NE


SECTION PLAT

330 Ft. from N. Line

_____ Ft. from S. Line

_____ Ft. from E. Line

330 Ft. from W. Line

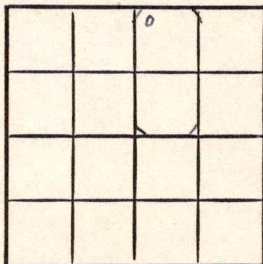

Sumner County

Location X

Rig up _____

Drilling and Remarks:

RECORD

Cased _____ in., _____ ft.

Sand _____

Gas _____

Oil _____

Total Depth _____

PRODUCTION

1st 24 hrs. Nat. _____

1st 24 hrs. after shot _____

Gas _____ Cu. Ft.

Dry Hole _____

Abandoned _____

Date

JAN 28 1948

19

S. J. LEWIS

Scout

Map No. 32 Sec. 35 Twp. 32 R. 4W

Well No. 1 Birkholz

Aladdin Pet. Company

ABANDONED Contractor

NW NE

E1128
SECTION PLAT

330 Ft. from N. Line

_____ Ft. from S. Line

_____ Ft. from E. Line

330 Ft. from W. Line

		0	

Sumner County

Location _____

Rig up _____

Drilling and Remarks:

Cr 4483

RECORD

Cased _____ in., _____ ft.

Sand _____

Gas _____

Oil _____

Total Depth 4570

PRODUCTION

1st 24 hrs. Nat. _____

1st 24 hrs. after shot _____

Gas _____ Cu. Ft.

Dry Hole _____

Abandoned _____

Date

FEB 25 1948

19

S. J. LEWIS Scout