
O.W.W.O. KANSAS Sumner

FORM 51 5M PETROL

Section 35 Township 32 Range 4W

Well No. 1 Springer

Company ~~Carter - Pure & Sun~~ Aladdin Pet.

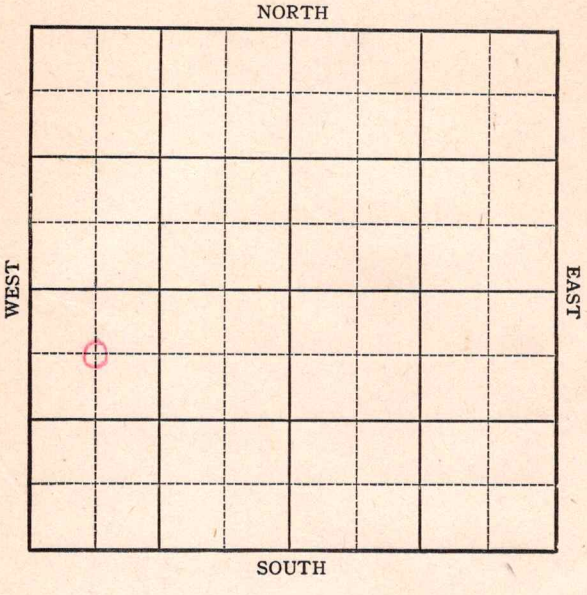

FORM 252 A
SM 3-45 PETROL

KANSAS

Sumner

Sec. 35 Twp. 32 S R. 4 W

Well No. #1 Springer Farm

CARTER-PURE & SUN Company


Wildcat

660' Ft. from N. Line

_____ Ft. from S. Line

_____ Ft. from E. Line

660' Ft. from W. Line

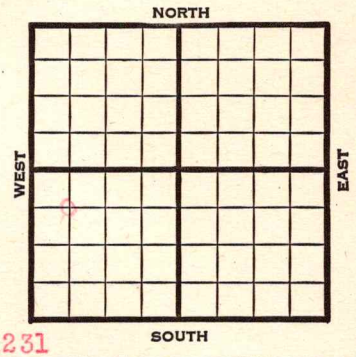

C NW SW Elev. 1231

1945	REPORT		
4-18	Location		
4/27	"		
5/3	"		
5/10	Drlg. 890'		
5/17	Wreford 1190		4303
	Drlg. 1818		1231
5/24	Hoover Sd	2445	3072
	Oread	2645	
	Douglas	2770	
	Drlg. 3022		
5/31	KC 3296		
	Drlg. 3515'		
6/8	Oswego 3620 Miss 3934 Kind 4223 Simp 4303- SO Drlg. 4312		
6/27	Arb. 4420		
	TD 4472'		

ABANDONED

S-513-A

O.W.W.O.

CO. Sumner ELEV. 1231

SEC. 35 TWP. 32 RGE. 4W

COMPANY Maddin Pet. NO. 1

FARM Springer

LOC. C NW SW

ABANDONED

NOV 20 '51

O.W.W.O.

O.W.W.O.

GEOL.

CONTR.

POOL

SPUD

CO. LSE. NO. SEC. TWP. RGE.

Old Info. Doug 2770, Lay 2980, Stal 2996, KC 3296, Csw 3620, Kl 3924, Kh 4223, Simp Sd. 4302, Arb. 4420, RTD 4472, Log D & A

6-22-45 New Info. Crowe Tools #1 rig MIRT to wash down NOV e 5" 4/39/150

NOTE 5/4058-59 900 gas

$25 Bulph + soil mt + est 35 MCF 22/4048-56 nonec 2/4002-03 nonec 2/3989-90

nonec 2/3987-88

nonec

D&A

FORM 26 200 BKS 1-44 PETROL

Kansas Pool Name Wildcat

Map No. 32 Sec. 35 Twp. 32 R. 4W

Well No. 1 Springer

Carter- Pure & Sun Company

FIRST REPORT Contractor

C NW SW


660 Ft. from N. Line

Ft. from S. Line

Ft. from E. Line

660 Ft. from W. Line

SECTION PLAT

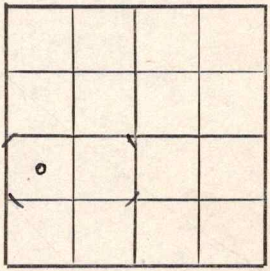

Sumner

Location X

Rig up

Drilling and Remarks:

RECORD

Cased in., ft.

Sand

Gas

Oil

Total Depth

PRODUCTION

1st 24 hrs. Nat.

1st 24 hrs. after shot

Gas Cu. Ft.

Dry Hole

Abandoned

Date

APR 1 8 1945 19

S. J. LEWIS Scout

FORM 26 200 BKS 2-44 PETROL

Kansas Pool Name Wildcat

Map No. 32 Sec. 35 Twp. 32 R. 4W

Well No. 1 Springer


Carter-Pure and Sun Company

ABANDONED Contractor

C NW SW

El. 1231

SECTION PLAT

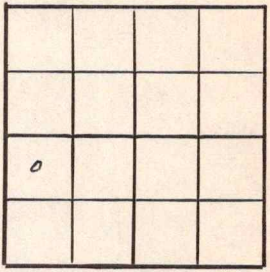

660 Ft. from N. Line

Ft. from S. Line

Ft. from E. Line

660 Ft. from W. Line

Sumner County

Location

Rig up

Drilling and Remarks:

Rec'd 4420

RECORD

Cased in., ft.

Sand

Gas

Oil

Total Depth 4472

PRODUCTION

1st 24 hrs. Nat.

1st 24 hrs. after shot

Gas Cu. Ft.

Dry Hole

Abandoned

Date

JUN 27 1945 19 S. J. LEWIS Scout

O.W.W.O.

S—513-A

CO. Sumner ELEV. 1231

SEC. 35 TWP. 32 RGE. 4W

COMPANY Aladdin Pet. NO. 1

FIRST REPORT

OCT 30

FARM Springer O.W.W.O.

LOC. C NW SW

GEOL. O.W.W.O.

CONTR.

POOL

SPUD

Old Info. Doug 2770, Lay 2980, Stal 2996, KC 3296, Osw 3620, Mi 3934, Kh 4223, Simp Sd. 4302, Arb. 4420, RTD 4472, Log D & A

6-22-45 New Info. Crowe Tools #1 rig MIRT to wash down

CO. LSE. NO. SEC. TWP. RGE.