

O.W.W.O.

KANSAS


Summer

FORM 51 5M PETROL

Section 35 Township 32 Range 4W

Well No. 1 Springer

Company Aladdin Peto
~~Carter - Pure & Sun~~

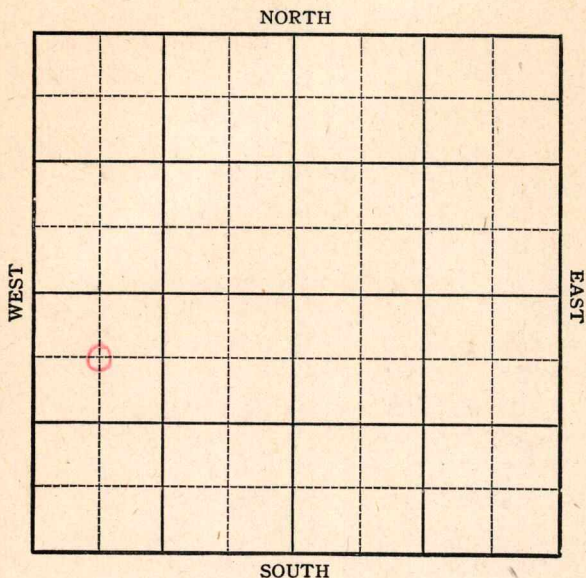

Sec. 35 Twp. 32 S R. 4 W

Well No. #1 Springer Farm

CARTER-PURE & SUN Company


Wildcat

660' Ft. from N. Line

_____ Ft. from S. Line

_____ Ft. from E. Line

660' Ft. from W. Line

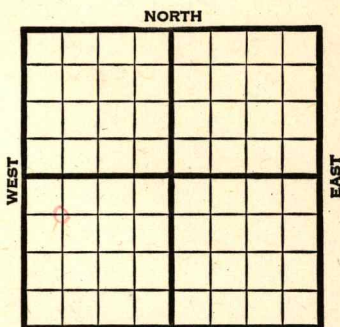

C NW SW Elev. 1231

REPORT

1945	
4-18	Location
4/27	"
5/3	"
5/10	Drlg. 890'
5/17	Wreford 1190
	Drlg. 1818
5/24	Hoover Sd 2445
	Oread 2645
	Douglas 2770
	Drlg. 3022
5/31	KC 3296
	Drlg. 3515'
6/8	Oswego 3620 Miss 3934 Kind 4223
	Simp 4303- SO Drlg. 4312
6/27	Arb. 4420
	TD 4472'

ABANDONED


Kansas Pool Name WildcatMap No. 32 Sec. 35 Twp. 32 R. 4WWell No. 1 SpringerCarter- Pure & Sun Company

FIRST REPORT

Contractor

C NW SW

SECTION PLAT

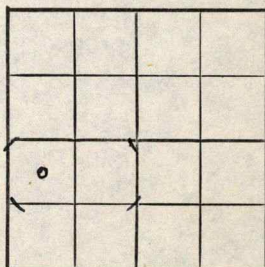660 Ft. from N. Line Ft. from S. Line Ft. from E. Line660 Ft. from W. Line

Sumner

Location XRig up

Drilling and Remarks:

RECORD

Cased in., ft.Sand Gas Oil Total Depth

PRODUCTION

1st 24 hrs. Nat. 1st 24 hrs. after shot Gas Cu. Ft.Dry Hole Abandoned

Date

APR 1 8 1945 19

S. J. LEWIS

Scout

Kansa Pool Name WildcatMap No. 32 Sec. 35 Twp. 32 R. 4WWell No. 1 SpringerCarter-Pure and Sun Company**ABANDONED**

Contractor

C NW SW

E1, 1231
SECTION PLAT

0			

660 Ft. from N. Line Ft. from S. Line Ft. from E. Line660 Ft. from W. LineSumner CountyLocation Rig up

Drilling and Remarks:

Per X 4420**RECORD**Cased in., ft.Sand Gas Oil Total Depth 4472**PRODUCTION**1st 24 hrs. Nat. 1st 24 hrs. after shot Gas Cu. Ft.Dry Hole Abandoned

Date

JUN 27 194519S. J. LEWISScout

CO. Summer ELEV. 1231SEC. 35 TWP. 32 RGE. 4WCOMPANY Aladdin Pet. NO. 1

FIRST REPORT

OCT 30 1977

FARM Springer

O.W.W.O.

LOC. C NW SWGEOL. O.W.W.O.

CONTR. _____

POOL _____

SPUD _____

Old Info. Doug 2770, Lay 2980, Stal 2996,
KC 3296, Osw 3620, MI 3934, Kh 4223, Simp
Sd. 4302, Arb. 4420, RTD 4472, Log D & A

6-22-45 | New Info. Crowe Tools #1 rig
MIRT to wash down

CO.

LSE.

NO.

SEC.

TWP.

RGE.

O.W.W.O.

CO. Summer ELEV. 1231
 SEC. 35 TWP. 32 RGE. 4W
 COMPANY Maddin Pet. NO. 1

ABANDONED

NOV 20 '57

FARM Springer

O.W.W.O.

LOC. C 1W SW

O.W.W.O.

GEOL. _____

CONTR. _____

POOL _____

SPUD _____

Old Info. Doug 2770, Lay 2980, Stal 2996,
 KC 3296, Csw 3620, MI 3934, Kh 4223, Simp
 3d. 4302, Arb. 4420, RTD 4472, Log D & A

6-22-45 New Info. Crowe Tools #1 rig
 MIRT to wash down NOV 6 '57 5" 4139/150

NOV 13 '57 NOV 20 '57 5/4058-59 900 gas

\$25 Bu ph + soil wt +
 est 35 MCF 22/4048

-56 more 2/4002-03

more 2/ 3989-90

more 2/ 3987-88

more

D&A

CO.

LSE.

NO.

SEC.

TWP.

RGE.