


Section 12 Township 32 Range 40W

Well No. #1 French "A"

Company Cities Service

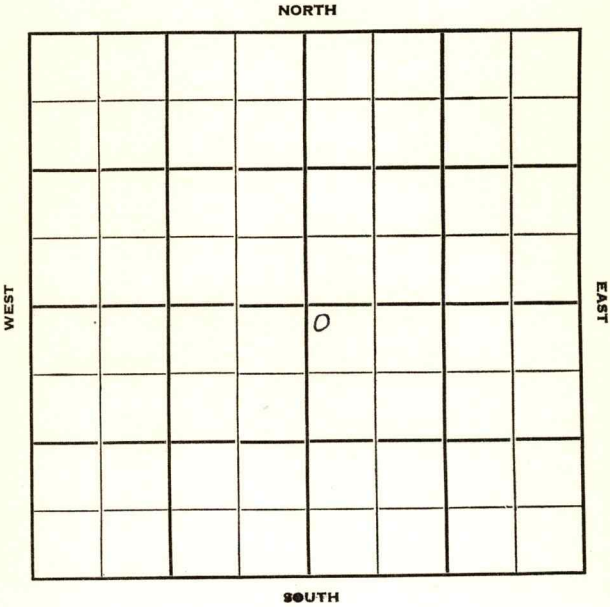

Morton

KANSAS

Sec. 12 Twp. 32 R. 40 W ✓

Well No. # 1 French "A" Farm _____

Cities Service

Company _____

Contractor _____


100 Ft. from N. Line

_____ Ft. from S. Line

_____ Ft. from E. Line

100 Ft. from W. Line

NW SE

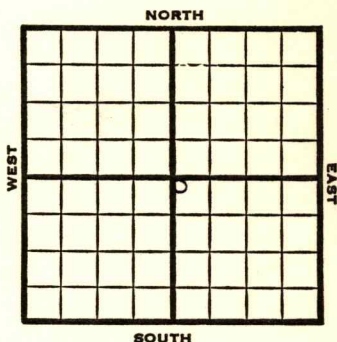

1951

Elev. 3294' REPORT

6/13

Location

8/8

Spud 6-13-51

Gas well TD 2630' 8" @ 535

5" @ 2629' TD 2630'

70/2576-90 4000 A test water

20/2546-50 50/2532-42

100/2508-28 55/2476-87

40/2462-70 40/2450-58

60/2416-28 30/2406-12

30/2396-2402

Krider 2360' Win. 2454'

Ft. Riley 2530'

25,000 A

Comp. 6,140,000 gas 396#

COMPLETED

County **Morton** State **Kansas**Sec. **12** (Blk. Twp.) **32** (Sur. Rge.) **40W** Map No.Operator **Cities Service**Well No. **1** Farm **French (A)**Elev. Location **NW SE****100** Ft. From **N** Line **SE****100** Ft. From **W** Line Quarter1st. Report **JUN 13 1951**

Completion

Remarks

Spudding Date

Drilg. Data

Location**J. E. TYRA**

County Morton State KansasSec. 12 (Blk. 32) (Sur. 4 Rge.) OW Map No.Operator Cities ServiceWell No. 1 Farm French "A"Elev. 3294 Location NW SE100 Ft. From N Line SE100 Ft. From W Line Quarter

1st. Report

Completion AUG 8 1951

Remarks

Spudding Date 6-13-51Drlg. Data Gas well TD 26308" @ 535 5" @ 2629 TD 263070/ 2576-90 4000 A test water20/ 2546-50 50/ 2532-42 100/ 2508-2855/ 2476-87 40/ 2462-70 40/ 2450-5860/ 2416-28 30/ 2406-12 30/ 2396-2402Krider 2360 Win. 2454 Ft. Riley 253025000 A Comp. 6,140,000 gas 396#

J. E. TYRA