

KANSAS


Morton cojnty

FORM 51 IOM 12-46 PETROL

Section 3 Township 32 Range 40-W

Well No. #1, Kansas Un "C"

Company Stanolind O&G Co.

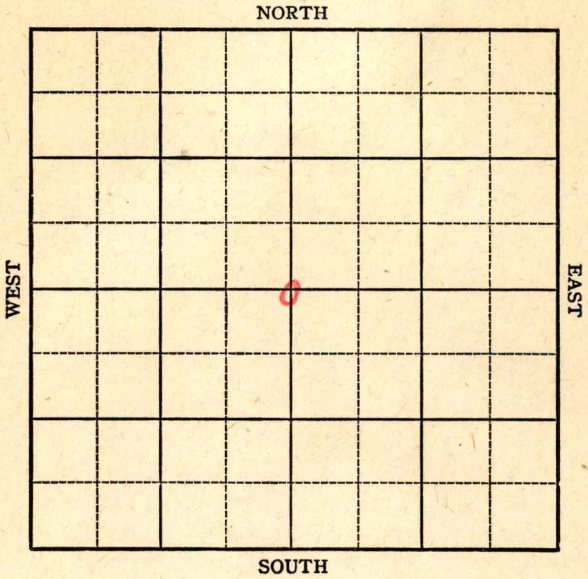

KANSAS

Morton County

Sec. 3 Twp. 32 R. 40WWell No. 1 Kansas Un "C" Farm

Stanolind

Company


Hugoton Pool

2640 Ft. from N. Line

Ft. from S. Line

2640 Ft. from E. Line

Ft. from W. Line

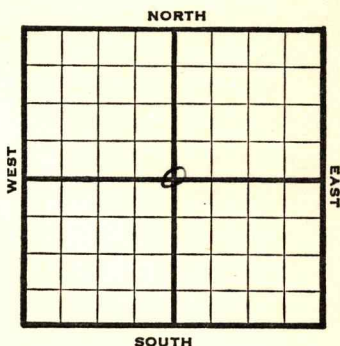

C. Section

1947

Elev. 3273'

REPORT

1/2 RUR

1/8 Drlg 2040'

1/15 8" @ 517

TD TD2325'

5" @ 2297

RUS

1/21 2000 Acid
Plug 2290

2/12 5" @ 2297

Perf

12,000 Acid

2,100,000 Gas

TD 2325'

COMPLETED

Map No. _____ Sec. 3 Twp. 32 R. 4 OW

Well No. 1 Kansas Un "C"

Stanolind Company

FIRST REPORT

Contractor

C Sec.


SECTION PLAT

2640 Ft. from N. Line

_____ Ft. from S. Line

2640 Ft. from E. Line

_____ Ft. from W. Line

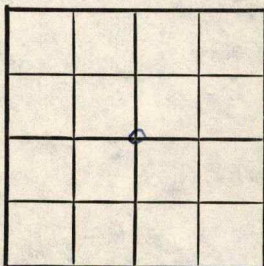

Morton County

Location _____

Rig up _____

Drilling and Remarks:

R U R

RECORD

Cased _____ in., _____ ft.

Sand _____

Gas _____

Oil _____

Total Depth _____

PRODUCTION

1st 24 hrs. Nat. _____

1st 24 hrs. after shot _____

Gas _____ Cu. Ft.

Dry Hole _____

Abandoned _____

Date

JAN 2 1947 19

S. J. LEWIS Scout

Map No. _____ Sec. 3 Twp. 32 R. 40W

Well No. 1 Kansas Un "C"

Stanolind Company


COMPLETE

Contractor

C Sec.

E 1-3228

SECTION PLAT

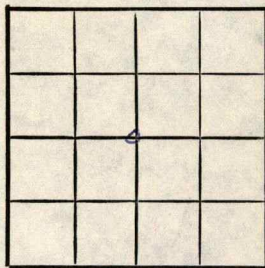

2640 Ft. from N. Line

_____ Ft. from S. Line

2640 Ft. from E. Line

_____ Ft. from W. Line

Morton County

Location _____

Rig up _____

Drilling and Remarks:

5' 02297

Perf.

120000000

2,100,000 Gas

RECORD

Cased _____ in., _____ ft.

Sand _____

Gas _____

Oil _____

Total Depth *2325*

PRODUCTION

1st 24 hrs. Nat. _____

1st 24 hrs. after shot _____

Gas _____ Cu. Ft.

Dry Hole _____

Abandoned _____

Date

FEB 12 1947

19

S. J. LEWIS

Scout