

Section 7 Township 32 Range 40W

Well No. #1 Dunn

Company Huber Corporation

NORTH

			0				

WEST

EAST

SOUTH

Sec. 7 Twp. 32 R. 40W

Well No. #1 Dunn Farm

Huber Corporation Company

Contractor

Hugoton Pool


Ft. from N. Line

330 Ft. from S. Line

330 Ft. from E. Line

Ft. from W. Line

SE SE NW

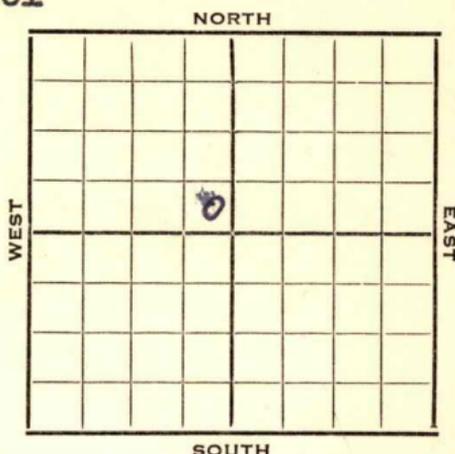

1953 **Elev. 3317'** REPORT

7/8 Location

7/22 13" @ 490'
Stuck @ 2047'

7/29 8" @ 2325
Drlg. 2814'

8/5 Drlg 4049'

8/12 **Her 2176, Win 2263, Ft. Riley 2310,
KC 3520**
Drlg 4910'
N.R.

9/16 Spud 7-12-53
Gas Well
TD 5500'
13" @ 490'
8" @ 2325'
**Her. 2176, Win 2263, Ft. Riley 2310,
KC 3520**
DST 5116-26 opn 1 hr, rec 3' mud, 445#
Morrow 5060, Miss 5462,
DST 5320-5404 opn 1 hr, rec 185' mud
1365#
TD 5500'
DST 5404-5500 opn 1 hr, rec 270' mud
1080' sw 1425# SP 2299

OVER

1953

Information brought forward.

9/16 76/ 2195-2214 40/ 2238-48 20/
2248-53 40/ 2253-64 1 mcfg
SP 2226
dol-frac
Comp. 6,530,000 gas 430#.

COMPLETED

