


Section 9 Township 32 Range 40-W

Well No. #1 Bishop

Company Stanolind

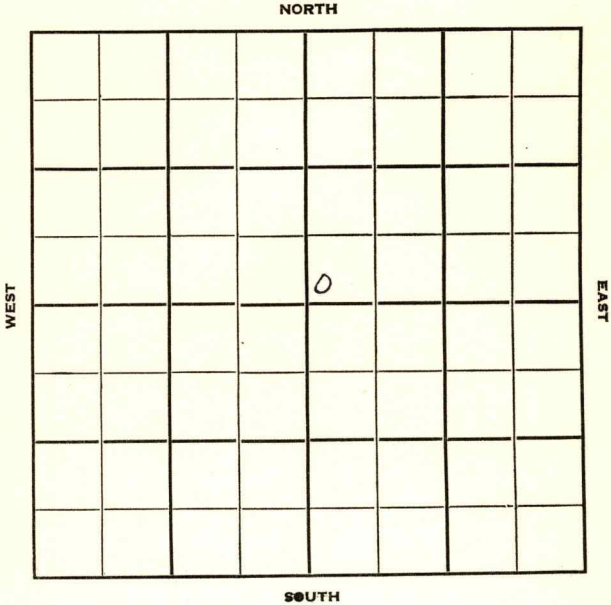

Morton

Sec. 9 Twp. 32 R. 40W ✓

Well No. #1 Bishop Farm

Stanolind Company

Hugoton Pool Contractor


Ft. from N. Line

150' Ft. from S. Line

Ft. from E. Line

150' Ft. from W. Line

SW NE

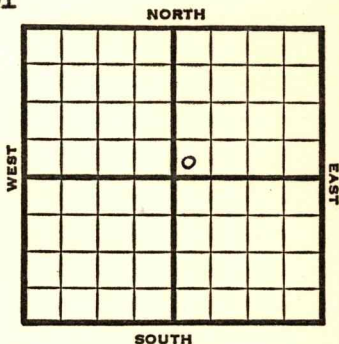

1951

Elev. 3294

REPORT

1/3

Location

1/31

Spud 1/4/51

Gas well TD 2310

10" @381

6" @2272

TD 2310

84/ 2154-68 78/ 2181-94

180/ 2216-46

Her. 2154 Win. 2216 Ft. Riley 2274

11000 A

Comp. 2,946,000 gas

COMPLETED

J. E. TYRA

County Morton State KansasSec. 9 (Blk.
Twp.) 32 (Sur.
Rge.) 40W Map No.Operator StanolindWell No. 1 Farm BishopElev. 3294 Location SW NE

COMPLETE

150 Ft. From S Line NE150 Ft. From W Line Quarter1st. ReportCompletion JAN 31 1951Remarks Hugoton PoolSpudding Date 1-4-51Drlg. Data Gas well TD 231010" @ 381 6" @ 2272 TD 231084/ 2154-68 78/ 2181-94 180/ 2216-46Her. 2154 Win. 2216 Ft. Riley 227411000 A Comp. 2,946,000 gas

J. E. TYRA