


KANSAS

Morton

Section 14 Township 32 Range 40-W

Well No. #1 Kelley

Company Stanolind

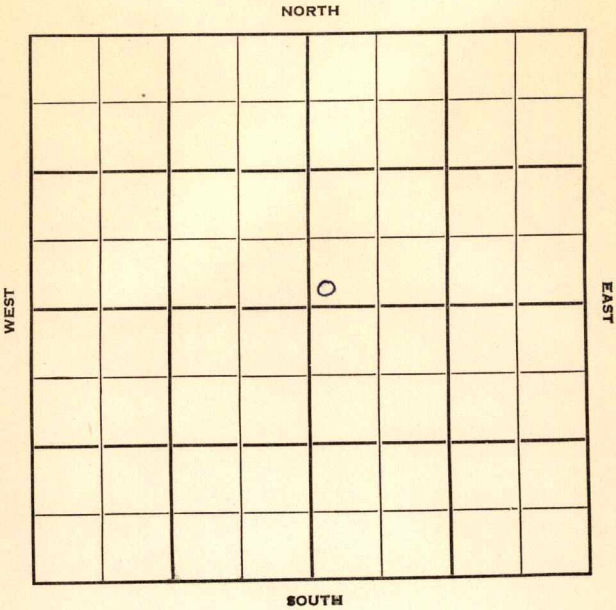

KANSAS

Morton

Sec. 14 Twp. 32 R. 40-W

Well No. #1 Kelley Farm

Stanolind Company

Hugoton Contractor


 Ft. from N. Line

150 Ft. from S. Line

 Ft. from E. Line

150 Ft. from W. Line

SW NE

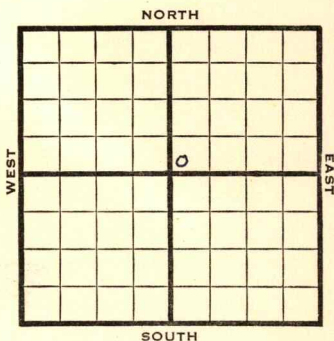

1950 **Elv. 3317'** REPORT

7/19 Location

9/13 Spud 8-8-50
Gas Well TD 2612'
10" @ 632'
Her. 2402-46' Win. 2461-2505
Ft. Riley 2526-64
TD 2612'
6" @ 2586'
36/2403-09 30/2422-27 60/2430-40
48/2462-70 24/2476-80 60/2486-96
24/2498-2502 24/2526-30
96/2542-58 19,500 total acid
Comp. 8,895,000 gas.

COMPLETED

Kansas


Map No. _____ Sec. 14 Twp. 32 R. 40WWell No. 1 KelleyStanolind

Company

Contractor

SW NE

SECTION PLAT

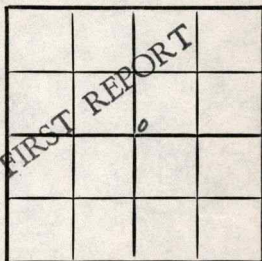

_____ Ft. from N. Line

150 Ft. from S. Line

_____ Ft. from E. Line

150 Ft. from W. LineMorton CountyLocation X

Rig up _____

Drilling and Remarks:

RECORD

Cased _____ in., _____ ft.

Sand _____

Gas _____

Oil _____

Total Depth _____

PRODUCTION

1st 24 hrs. Nat. _____

1st 24 hrs. after shot _____

Gas _____ Cu. Ft.


Dry Hole _____

Abandoned _____

Date

JUL 19 195019J. E. TYRA

Scout

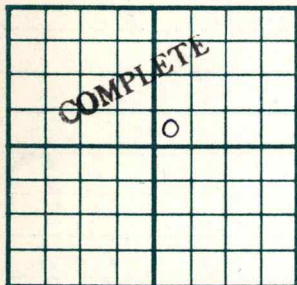County Morton State KansasSec. 14 (Blk.
Twp.) 32 (Sur.
Rge.) 40W Map No.Operator StanolindWell No. 1 Farm KelleyElev. 3317 Location SW NE150 Ft. From S Line NE150 Ft. From W Line Quarter

1st. Report

Completion SEP 13 1950

Remarks

Hugoton PoolSpudding Date 8-8-50Drlg. Data Gas well TD 261210" @ 632 Her. 2402-46 Win. 2461-2505Ft. Riley 2526-64 TD 2612 6" @ 258636/ 2403-09 30/ 2422-27 60/ 2430-4048/ 2462-70 24/ 2476-80 60/ 2486-9624/ 2498-2502 24/ 2526-30 96/ 2542-5819500 total acidComp. 8,895,000 gas

J. E. TYRA