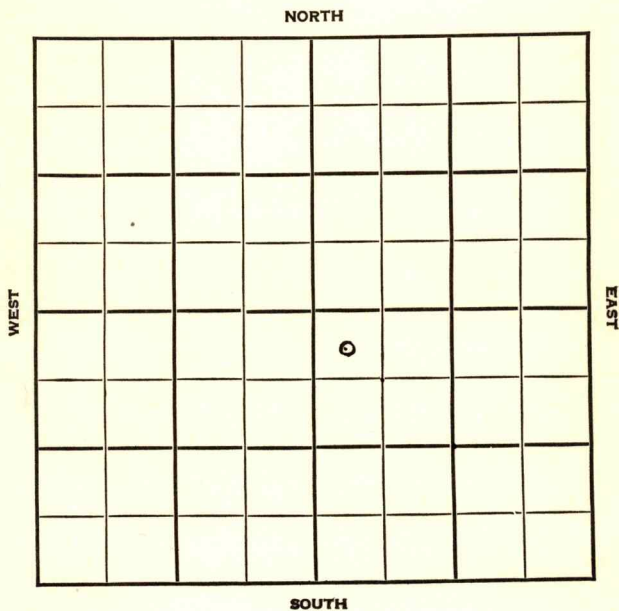


KANSAS

Section 17 Township 32 Range 40WWell No. #1 E. BearCompany Stanolind

Sec. 17 Twp. 32 R. 40W

Well No. #1 E. Bear Farm

Stanolind Company
Hugoton


390 Ft. from N. Line

Ft. from S. Line

Ft. from E. Line

330 Ft. from W. Line

NW SE

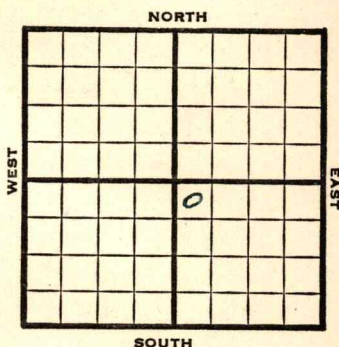

1948

E1 3338'

REPORT

1/14 Miss. test.

RUR

1/21 Drlg. 320'

1/26 13" @ 430'
WOC

2/4 **Ft. Riley 2397'**
8" @ 2397'
Drlg. 2500'

2/11 Drlg. 3650'
2/18 **Lansing 3540'?**
Drlg 4500'

2/25 **Sand 4991'**
Drlg. 5017' S Gas.

3/3 **Norris Shale 5124'**
Morrow Sandy Lime 5334'-5388'

3/10 Drlg. 5437'

3/17 **Sand 5482-87'**
Mississippi 5499'
Drlg. 5563'
Herington 2208'
Krider 2225'
Windfield 2268'

3/24 Drlg. 5685'

OVER

1948

3/31 TD 5905'
SD

4/7 "

4/14 Drlg. 6206'

4/21 **Viola 6890'**
Drlg. 6446'

4/28 **Simpson sdy shale 6500'**
Arbuckle 6505'
TD 6561'
1620' W
PB 4970'
Run Casing.

5/5 "

5/12 "

5/19 "

5/26 "

6/1 "

6/9 "

6/16 "

6/23 TD 6561'
Completed in Penn Sol
3,900,000 gas
1425# R pr.
✓ 23 bbls dist.
50° Gr.
Comp

COMPLETED

Map No. _____ Sec. 17 Twp. 32 R. 40W

Well No. 1 E. Bear

Stanolind Company

FIRST REPORT Contractor

NW SE

SECTION PLAT

330 Ft. from N. Line

_____ Ft. from S. Line

_____ Ft. from E. Line

330 Ft. from W. Line

		0	

Morton County

Location _____

Rig up _____

Drilling and Remarks:

Miss. test

R U R

RECORD

Cased _____ in., _____ ft.

Sand _____

Gas _____

Oil _____

Total Depth _____

PRODUCTION

1st 24 hrs. Nat. _____

1st 24 hrs. after shot _____

Gas _____ Cu. Ft.

Dry Hole _____

Abandoned _____

Date

JAN 14 1948

19

S. J. LEWIS

Scout

Map No. _____ Sec. 17 Twp. 32 R. 40W

Well No. 1 E. Bear

Stanolind

Company

COMPLETE

Contractor

NW SE


E 1, 2328
SECTION PLAT

330 Ft. from N. Line

_____ Ft. from S. Line

_____ Ft. from E. Line

330 Ft. from W. Line

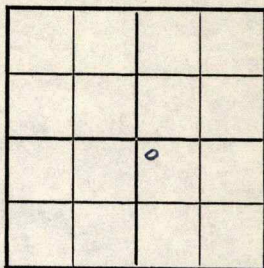

Morton County

Location _____

Rig up _____

Drilling and Remarks:

*Completed in
Perm. Sal.*

3,900,000 gal

1425° R₂

+ 23 1/2 lb. in. test

50° R₂

RECORD

Cased _____ in., _____ ft.

Sand _____

Gas _____

Oil _____

Total Depth 6561

PRODUCTION

1st 24 hrs. Nat. _____

1st 24 hrs. after shot _____

Gas _____ Cu. Ft.

Dry Hole _____

Abandoned _____

Date

JUN 23 1948 19

S. J. LEWIS Scout