


Section 18 Township 32 Range 40 W

Well No. # 1 Church

Company Huber Corp

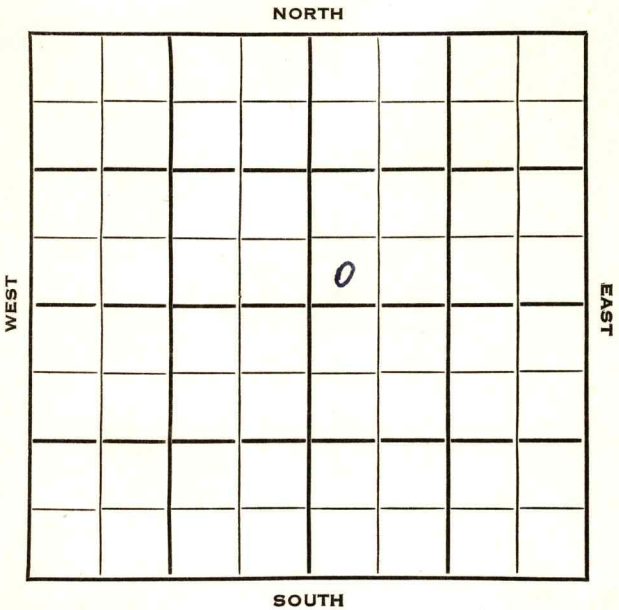

Sec. 18 Twp. 32 R. 40W ✓

Well No. #1 Church Farm

Huber Corp. Company

Contractor

Wildcat

Ft. from N. Line

330 Ft. from S. Line


Ft. from E. Line

330

Ft. from W. Line

SW SW NE

Stanolind farmout

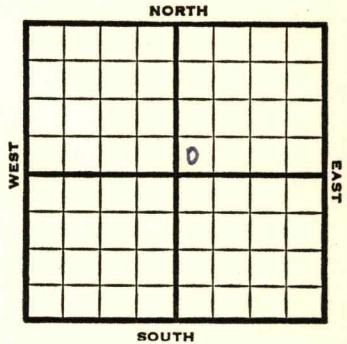

1953 Elev. 3357'

REPORT

5/20 Location

5/28 Drlg. 1652'

6/3 Her 2236 Win 2284 Up ft. 2369
Low Ft. 2410 8" @ 2420
Drlg. 3233'

6/10 DST 3252-75, 1 hr, 15' M 245' SW
520# Top 3196 Lans 3538
DST 3893-3908, 1 1/4 hr, 385' SW 805#
DST 3923-33, 40 mins, 450' SW 885#
Drlg. 4724'

6/24 NR

7/1 "

7/29 Spud 5-22-53

Gas Well

TD5825

13" @ 480

Her 2236, Win 2284, Ft Riley 2369
8" @ 2420

DST 3252-75, opn 1 hr., rec. 15' mud
245' sw, 520#

Top 3196, Lans 3538

DST 3893-3908, opn 1 1/4 hrs., rec.
385' sw, 805#

DST 3923-33, opn 40", rec. 450' sw,
885#

Morrow sh 5173

OVER

(Information Brought Forward)

1953

7/29

DST 4968-5022, opn 1 hr., rec. 25' mud,
DST 5335-5485, opn 35 mins., gas in 5"
7 mcfg spray of dist.

145' gcm, 1496#

TD 5825

5" @ 5540, **Chester 5620**

24/5456-62, 8/5408-10, 8/5404-06,
8/5400-02

Atoka 4780, Morrow 5218

Comp. $12\frac{1}{2}$ mcfgpd 1269#

COMPLETED

78

of

Q.

330 Ft. From S Line NE

330 Ft. From W Line Quarter

1st. Report

Completion JUL 29 1953

Remarks Wildcat

Spudding Date 5-22-53

Drlg. Data Gas well TD 5825

13" @ 480 Her. 2236 Win. 2284

Ft. Riley 2369 8" @ 2420 DST 3252-75

open 1 hr. Rec. 15' mud 245' sw 520#

Top. 3196 Lans. 3538 DST 3893-3908

open $1\frac{1}{4}$ hr. Rec. 385' sw 805# DST 3923-

33 open 40 min. Rec. 450' sw 885#

Morrow sh. 5173 DST 4968-5022 open 1 hr.

Rec. 25' mud DST 5335-5485 open 35 min.

gas in 5 min. 7 mcfg spray of dist.

145' g cm 1496# TD 5825 5" @ 5540

Chester 5620 24/ 5456-62 8/ 5408-10

8/ 5404-06 8/ 5400-02 Atoka 4780

Morrow 5218 Comp. $12\frac{1}{2}$ mcf gpd 1269#

J. G. McGEHEE