


Section 18 Township 32 Range 40W

Well No. #2 Church

Company J.M. Huber Corp.

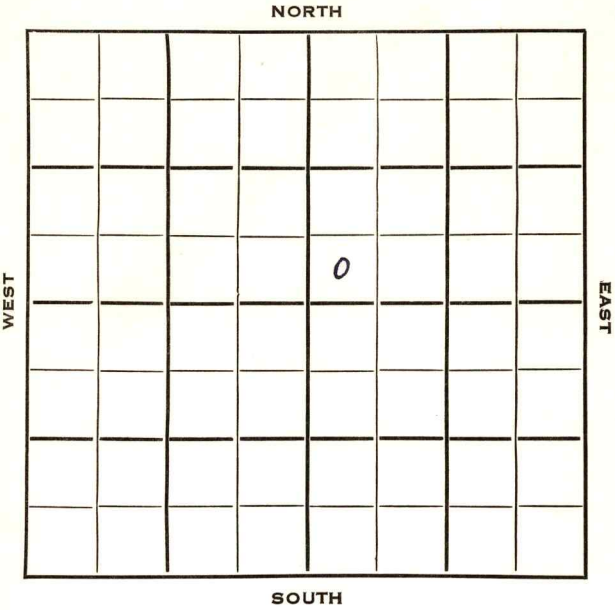

Morton KANSAS

SEC.	TWP.	R.
18	32	40W ✓

WELL NO.

2 Church

FARM

COMPANY

J. M. Huber Corp.

CONTRACTOR


Midwestern
Hugoton Pool

_____ Ft. from N. Line

100 _____ Ft. from S. Line

_____ Ft. from E. Line

100 _____ Ft. from W. Line

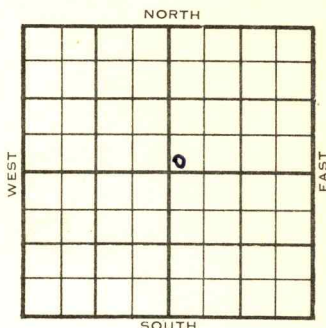SW SW NE (TWIN)
Stanolind F/O

	ELEVATION	REPORT
1954	3355'	

3/24 Spud 3-22-54
Drlg. 403/31 RTD 2360'
5" @ 2358'Her. 2238', Win 2284', Tow 2354'
WOCT.

4/7

4/28 Spud 3-22-54 Gas well TD 2368
 8" @ 480 Her. 2238 Win. 2284
 Tow. 2354 TD 2360 5" @ 2358
 CO to 2368 2000 A 400,000 CFG
 10 BSWPH 72/2299-2317 36/2283-92
 jet-frac. PB 2270 88/2238-60
 jet-frac. CO to 2320 750,000 CFG
 Comp. 2½ MCFGPH

COMPLETED

County	Morton		State	Kansas	
Sec.	18	(Blk. Twp.)	32	(Sur. Rge.)	40W Map No.
Operator	J. M. Huber Corp.				
Well No.	2	Farm	Church		
Elev.	Location		SW SW NE (twin well)		


100 Ft. From S Line NE
100 Ft. From W Line Quarter
MAR 24 1954
1st. Report

Completion

Remarks Stanolind farmout
Midwestern - Contr.

Spudding Date 3-22-54


Drlg. Data

Hugoton Pool

drlg. 40

J. G. McGEHEE

County Morton State Kansas
 Sec. 18 (Blk. 3 2 (Sur. 40W Map No.
 (Twp. Rge.)
 Operator J. M. Huber Corp.
 Well No. 2 Farm Church
 Elev. 3355 Location SW SW NE (twin well)

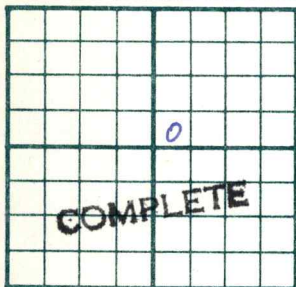

100 Ft. From S Line NE
100 Ft. From W Line Quarter
 Ist. Report
 Completion APR 28 1954
 Remarks Hugoton Pool
Mid-Western - Contr.
 Spudding Date 3-22-54

Drlg. Data Gas well TD 2368
8" @ 480 Her. 2238 Win. 2284
Tow. 2354 TD 2360 5" @ 2358 CO to 2368
2000 A 400,000 cfg 10 bswph 72/ 2299-
2317 36/ 2283-92 jet-frac PB 2270
88/ 2238-60 jet-frac CO to 2320
750,000 cfg Comp. 2 $\frac{1}{2}$ mcf/gpd

J. G. McGEHEE