KANSAS


FORM 51 IOM 12-46 PETROL

Morton county.

Section 23 Township 32 Range 40-W

Well No. #1, Tennis

Company Stanolind Oil and Gas Company

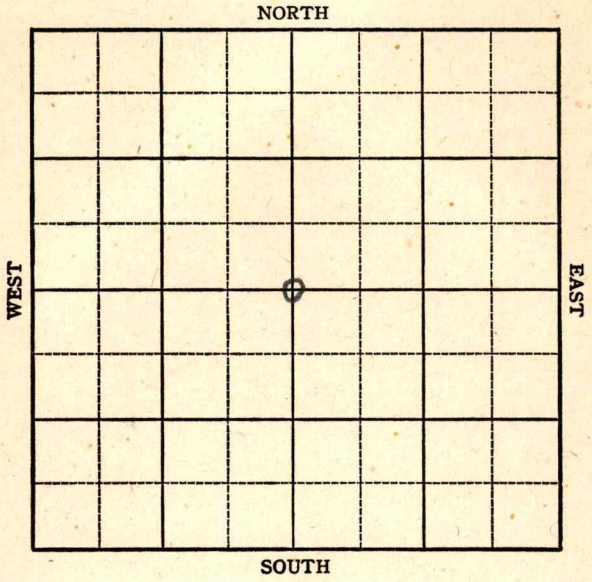

FORM 252-A
5M 8-45 PETROL

KANSAS

Morton

Sec. 23 Twp. 32 R. 40-W

Well No. #1, Tennis Farm

Stanolind Company

Hugoton Pool


2640 ' Ft. from N. Line

Ft. from S. Line

2640' Ft. from E. Line

Ft. from W. Line

C section

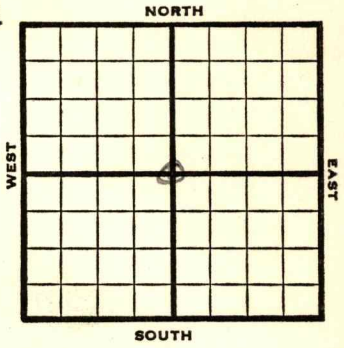

1947	Elev. 3306 **REPORT**
1/22	8" @ 558' WOC
2/12	5" @ 2527' Perf 13,500 Acid 1,800,000 Gas 400# R Pr TD 2558'

COMPLETED

Form 26 200 Bks. 10-46 Petrol

Kansas

Hugoton Pool

KANSAS

Map No. _____ Sec. 23 Twp. 32 R. 40W


Well No. 1 Tennis

Stanolind Company

IRST REPORT Contractor

C Sec.

SECTION PLAT

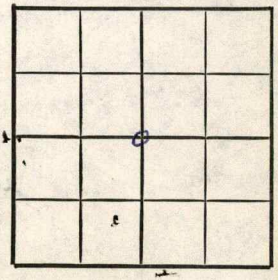

2640 Ft. from N. Line

_____ Ft. from S. Line

2640 Ft. from E. Line

_____ Ft. from W. Line

Morton County

Location _____

Rig up _____

Drilling and Remarks:

8" @ 558 WOC

RECORD

Cased _____ in., _____ ft.

Sand _____

Gas _____

Oil _____

Total Depth _____

PRODUCTION

1st 24 hrs. Nat. _____

1st 24 hrs. after shot _____

Gas _____ Cu. Ft.

Dry Hole _____

Abandoned _____

Date

JAN 2 2 1947 19 S. J. LEWIS Scout

Form 26 200 Bks. 10-46 Petrol KANSAS Hugoton Pool
Kansas

Map No. _____ Sec. 23 Twp. 32 R. 40W

Well No. 1 Tennis


Stanolind Company

COMPLETE Contractor

C Sec.

E1.3306

SECTION PLAT

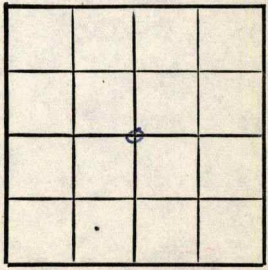

2640 Ft. from N. Line

Ft. from S. Line

2640 Ft. from E. Line

Ft. from W. Line

Morton County

Location

Rig up

Drilling and Remarks:

5" @ 2527

Perf.

1800 Rock

1,800,000 Gas

400 # RP

RECORD

Cased _____ in., _____ ft.

Sand

Gas

Oil

Total Depth 2558'

PRODUCTION

1st 24 hrs. Nat.

1st 24 hrs. after shot

Gas _____ Cu. Ft.

Dry Hole

Abandoned

Date

FEB 12 1947 19

S. J. LEWIS Scout