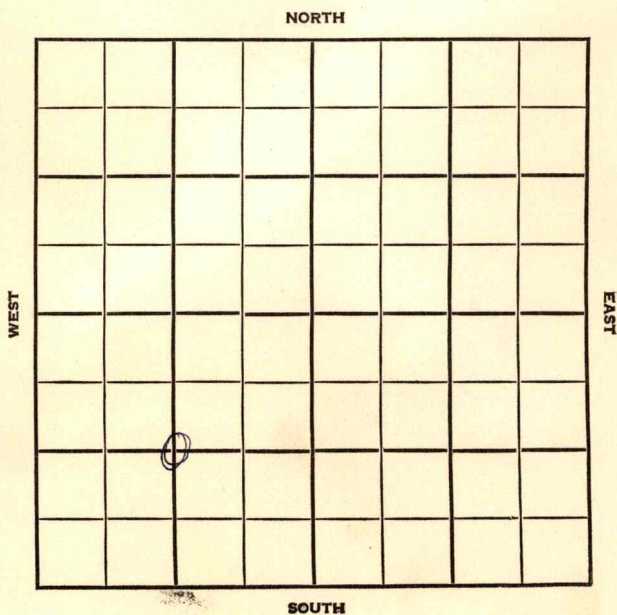


Section 23 Township 32 Range 41WWell No. #2 Lemon Gas Unit "C"Company Stanolind Oil & Gas

County Morton Elev. 3404
 Sec. 23 Twp. 32 Rge. 41W
 Company Stanloind Oil & Gas
 Farm Name Lemon Gas Unit "C" No. 2

TOPS	DEPTH	LOG	DATUM	Loc. in Sec.
Anh.				C SW
Tr.				
Dg.				
Bl.				
L.				
K.C. <u>MWrd</u>	<u>5052</u>			Geol.
B.K.C. <u>KEYOS</u>	<u>5195</u>			Concr.
Ce.				
C.				
M.	<u>5250</u>			
M.				Pool
K.				Richfield
Mz.				
Mq.				
V.				
S.				
S.				
A.				
R.				
PE.				
G.				
T.D.	<u>5300</u>			

COMPLETE
 MAR 6 '57

Date Comm. WOGR DEC 5 '56 DEC 12 '56 12-7-56
13 3/4 @ 458 1448 DEC 19 '56
9" @ 1487/100 2910 DEC 26 '56
DIST 3130-3245 1hr. rec 40' Md
N-S BHP 510/30 3656 JAN 2 '57
5300 JAN 9 '57 DIST 5200-5300 20"
6/3" ga 5.660 MCM rec 130'
GCM + 180' dist 56CM BHP
1310/30 7" @ 5293/ C.O. JAN 15 '57

CO 5265 40/5200-10 36/5221-29

9a 70 MCF thru 3" Tbg PB 5180

24/5162-68 9a 7,800 MCF 100

add + Frac 15x15 9a 12,530

MCF thru 7" CSG JAN 23 '57 PB 5150

20/5132-37 Frac 10x15 PB

5115 48/5098-5106 Frac 15x10

NT. CO 5265 9a 22,879

MCF thru 7" CSG JAN 30 '57 FEB 6 '57

FEB 13 '57 FEB 20 '57 S.I. FEB 27 '57 MAR 6 '57

4 point back press test

31,600 MCF GPD.

County Morton Elev. _____
 Sec. 23 Twp. 32 Rge. 41W
 Company Stanloind Oil & Gas
 Farm Name Lemon Gas Unit "C" No. 2

TOPS	DEPTH	LOG	DATUM	Loc. in Sec.
Anh.				C SW
TP.				
H.				
Tr.				
Dg.				
Bl.				
L.				Geol.
K.C.				Contr.
B.K.C.				
Ce.				
C.				
M.				
M.				Pool
K.				Richfield
Mz.				
Me.				
V.				
S.				
S.				
A.				
R.				
Pe.				
G.				
TD.				

FIRST REPORT

NOV 28 '56

Date Comm.

WOGR

34