


Morton

KANSAS

SECTION 27 TOWNSHIP 32 RANGE 41W

WELL NO. #1 J.C. Lemon

COMPANY Pan-American Petr.

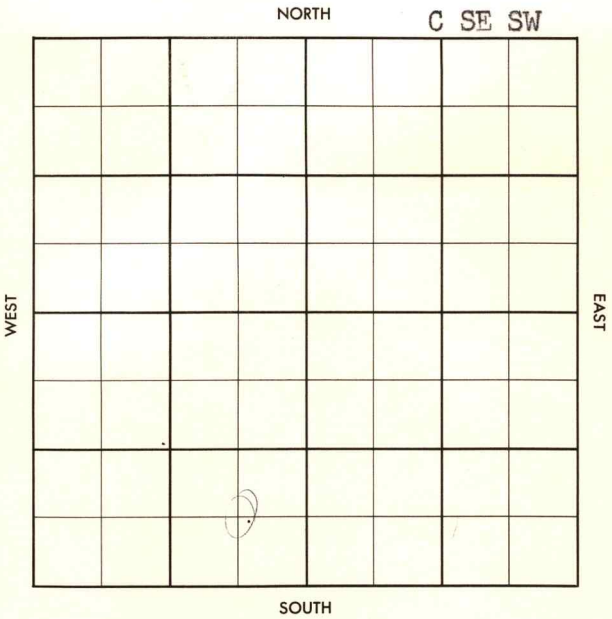

County Morton Elev. 3401 RB
 Sec. 27 Twp. 32 Rge. 41W
 Company Pan-American Pet.
 Farm Name J. C. Lemon No. 1

TOPS	DEPTH	LOG	DATUM	Loc. in Sec.
Anh.				C S E SW
TP.				
H.				
Tr.				
Dg.				
Bl.				
L.				Geol.
K.C.				Contr.
B.K.C.				
Ce.				
C.				
M.				
M.				Pool
K.				Richfield
Mz.				
Me.				
V.				
S.				
S.				
A.				
R.				
PE.				
G.				
T.D.				

FIRST REPORT	
FEB 27 '57	
0	

Date Comm. 2-23-57

8" @ 520/100

34

3398 DF

County Morton Elev. 3401 RB
 Sec. 27 Twp. 32 Rge. 41W
 Company Pan-American Pet.
 Farm Name J. C. Lemon No. 1

TOPS	DEPTH	LOG	DATUM	Loc. in Sec.
Anh.				C SE SW
Tp.	3125	3128		
H.				
Tr.				
Dg.				
BL.				
L. - <u>Greenwood</u>	3447	3448		Geol.
M.C.	<u>Mo</u>	3608		Contr.
B.K.C.	<u>DM</u>	4279		
Ce.		4460		
C.				
M.W.		4954		Pool
M.		5132		Richfield
K.				
Mz.				
Me.				
V.				
S.				
S.				
A.				
R.				
Pe.				
G.				
T.D.				

ABANDONED

MAR 20 '57

Date Comm. 2-23-57

8" @ 520/400 MAR 6 '57 10 3590 MAR 13 '57

DST 4380-4425 (30) rec 10' M

FP 0-10 BHP 17 (30)

DST 4594-4650 (60) rec 100' M

FP 30-80 BHP 750 (30) DST

4830-5140 (60) rec 40' M BHP 400

C 4983-5021 ATO 5140 MAR 20 '57

D.E.A