


DX 78-1 Morton

KANSAS

Section 26 Township 32 Range 41W

Well No. #1 Going

Company Panhandle Eastern

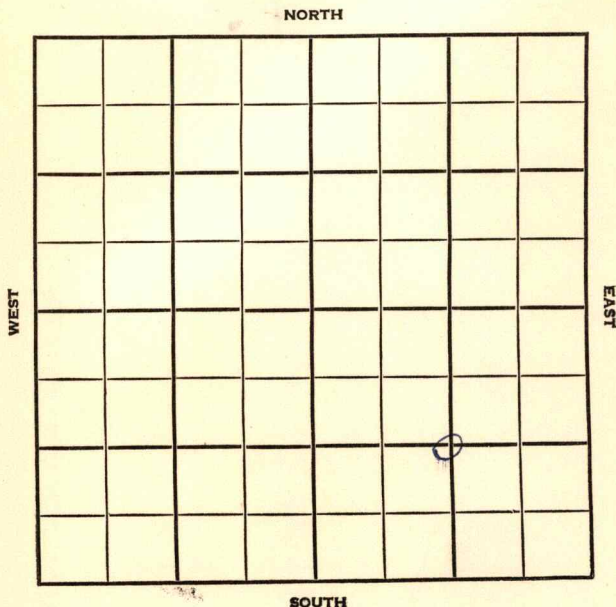

Morton

KANSAS

SEC.

26

TWP.

32

R.

41W

WELL NO.

#1 Going

FARM

COMPANY

Panhandle Eastern

CONTRACTOR

Holm

Hugoton


_____ FT. FROM N. LINE

_____ FT. FROM S. LINE

_____ FT. FROM E. LINE

_____ FT. FROM W. LINE

C SE/4

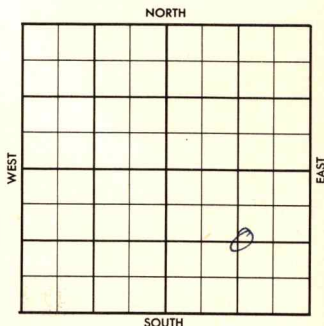

1956

ELEVATION

REPORT

7-18

Location

County Morton Elev. 3418
 Sec. 26 Twp. 32 Rge. 41W
 Company Panhandle Eastern
 Farm Name Goins No. 1

TOPS	DEPTH	LOG	DATUM	Loc. in Sec.
Anh. <u>KFI</u>		<u>3160</u>		<u>C SE 1/4</u>
Tp. <u>WFD</u>		<u>2216</u>		
H. <u>UFFB</u>		<u>2290</u>		
Tr. <u>W2</u>		<u>2878</u>		
Dg. <u>TP</u>		<u>3122</u>		
BL.				
L.		<u>3652</u>		
K.C. <u>Marm</u>		<u>4238</u>		Geol.
B.K.C.				Contr.
Ce.		<u>4404</u>		<u>Holm</u>
C. <u>MW</u>		<u>4758</u>		
M. <u>" 3d</u>		<u>5040</u>		Pool
M. <u>" 6" 3d</u>		<u>5159</u>		
K. <u>Keyes</u>		<u>5191</u>		<u>Hutton</u>
Mz. <u>Miss</u>		<u>5230</u>		
Me.				COMPLETE OCT 3 '56
V.				
S.				
S.				
A.				
R.				
Pe.				
G.				
T.D.	<u>5280</u>	<u>5279</u>		

Date Comm.

Location JUL 25 '56 7-14-56 85781484/250 AUG 1 '56 DST 3152-7645" 9/7" ga 277 MCF/45"rec 70' Md 500/20" 3510AUG 8 '56 DST 4286-4317 1 hr9/13" ga 490 MCF/5" 723MCF in 1 hr rec 15' 6 CMBHP 980/20 DST 4364-442345" 9/1 1/2" ga 1.22 MCF/5"

end test 1.634 MCF sec 10'
 GCM BHP 1030/20 DST
 4434-4500 lhr sec 10' 56 CM
 BHP 0 DST 4569-4823
 45" sec 50' Md BHP 0 DST
 5066-5130 65" 9/13" ga
 1.862 MCF/15" 2.252 MCF
 in 50" sec 310' GCM + 120
 GCSW BHP 1170/25" DST
 5142-80 20" 9/12" ga.
 2.544 M/10" 4.732 MCF
 in 15" BHP 1320/20" DST
 5197-5230 20" 9/11" ga
 7.780 MCF/4" sec 2' dist.
 BHP 1630/20"

(2 zone disc.)

AUG 15 '56 5 1/2 @ 5279 GRNU
 AUG 22 '56 120/5192-5222 ga 10.375
 1 ga 11.712 M FV ac 15 x 15
 ga 13.350 MCF CP 10.50 #
 cal op Flw 61.944 MCF AUG 29 '56
 SEP 5 '56 SEP 12 '56 SEP 19 '56 SEP 26 '56 OCT 3 '56
 cal op Flw 97.800 MCF
 + 8 B dist per mill.
 SIP 1169 #

36-32-41W

CAL/4

County Morton Elev. _____
 Sec. 26 Twp. 32 Rge. 41W
 Company Panhandle Eastern
 Farm Name Going No. 1

TOPS	DEPTH	LOG	DATUM
Anh.			
Tp.			
H.			
Tr.			
Dg.			
BL.			
L.			
K.C.			
B.K.C.			
Ce.			
C.			
M.			
M.			
K.			
Mz.			
Me.			
V.			
S.			
S.			
A			
R.			
Pe.			
G.			
T.D.			

Loc. in Sec. _____

C SE/4


Geol. _____

Contr. _____

Holm

Pool _____

Hugoton

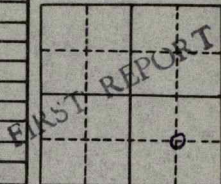

Date Comm. _____

JUL 18 '56

Location _____

JUL 25 1956

34