

Morton


KANSAS

SECTION 27 TOWNSHIP 32 RANGE 41W

WELL NO. #1 Bawker Gas Unit

COMPANY Vickers Petr.

NORTH

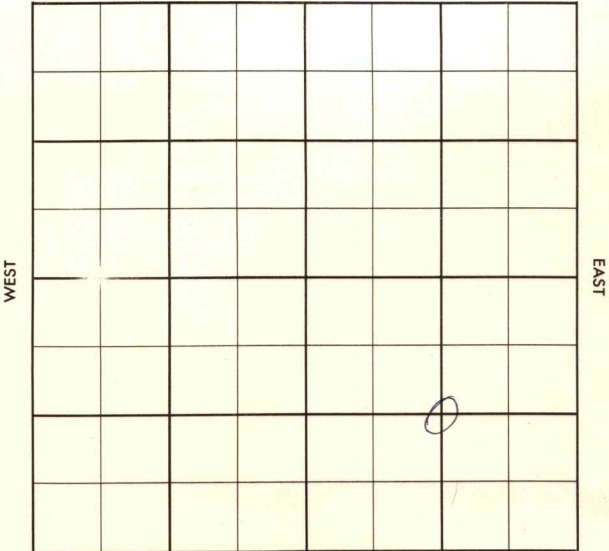

SOUTH

County Morton Elev. 3403
 Sec. 27 Twp. 32 Rge. 41W
 Company Vickers Pet.
 Farm Name Bawker Gas unit No. 1

TOPS	DEPTH	LOG	DATUM	Loc. in Sec.
Anb.	991			C SE/4
TP.				
H. <u>L. Krid</u>		2166		
Tr. <u>WFM</u>		2204		
Dg. <u>WAB</u>		2870		
Bl. <u>5107</u>		3122		
L. <u>TP</u>		3269		
K.C.				Geol.
B.K.C.				Contr.
Ce.				Nye & Snell
C.				Pool
M. <u>MW 3h</u>	4818	4811		Richfield
M. <u>" sd</u>	4959-67	4940		
K. <u>M133</u>	5299	5284		
M. <u>ST GEN</u>	5336	5318		
Mo. <u>Keyes sd</u>		5230		
V.				
S.				
S.				
A.				
R.				
PE.				
G.				
TD.	5386			

COMPLETE

MAY 8 57

Date Comm. 12-18-56Vickers 50%, Stanolind 25%, Champlin 25%RUR DEC 26 56 9 5/8 1248/750DST 2167-2231 30" 6 1/4" 90'100 MCFG end of 1st sec 250'Md BHP 900/20" @ 2635 JAN 2 57DST 2888-2925 @ 45" sec 150'Md BHP 420/20" DST 3148-83at 1hr sec 150' GCM BHP 490120' @ 4177 JAN 9 57 DST 4816-4974

1 hr 2500' GSSY OCM BHP 1480/30'
 P JAN 16 '57 DST 5106-49 op 45"
 rec 92' Mud BHP 1135/30"
 DST 5240-5322 op 1 hr G/2"
 ga 4.165 MCF/15" ga 4.260/60"
 rec 35' G & dist cut Mud + 60'
 dist FP 1280 BHP 1435/30"
~~57~~ @ 7" @ 5335/450 JAN 23 '57 M/G
 JAN 30 '57 CO 5299 64/5232-48
 4 hr B.D. ga 8.770 MCFG thru
 2" tbg. PB 5215 28/5195
 -5202 ga 223 MCFG + 1 1/2
 Gwph + 550 24/5185-91 ga
 246 MCF + 4 1/2 Gwph + 550
 48/5158-62 ga 267 MCF +
 4 1/2 Gwph + 50. oil 72/5128
 -46 All PFS ga 286 MCFG
 + 2 1/2 Gwph + 50. oil FEB 6 '57
 Frac 15 x 13 & Ld. FEB 13 '57 ga
 179 MCF PKI @ 5172 ga
 179 MCFG re set PKI @ 5192
 ga 112 MCFG Retainer @
 5100 sqd All PFS. (5238-48
 still open) FEB 20 '57 sqd ~~ALL PFS~~
 CO 5210 PB 5205 Re sqd.
 (5238-48 still open) FEB 21 '57 32/
 4941-48 Flwd 6.68 Bo in 1 hr
 died & 91 Bo in 10 hrs 3% wth
 & Av. 9 Boph no/w ga 41°
 sqd 4941-49 CO 5206 40/5130
 27-32-41 C se/4

-40 20 Blitz 5130-40 MAR 6 '57
 PKR @ 5152 1/2 \$ 31 BW +
 10 MCFG in 9 hrs 509 MAR 13 '57
 CO 5206 Temp/BTP 2410 sq WOL MAR 20 '57
 Resq CO 2645 52/2220
 -33 B 5 Gwph \$ MAR 27 '57 ✓
 CO ~~2405~~ Resqd CO 2405
 52/2220-33 B 5 Gwph
 50/2203-17 \$ 43 GW in 1 hr
 + 55G FRAC 6 X 6 1/2 \$ 4 1/4 X 1/4
 + 9a 189 MCFG SIP 350 #
 9a 267 MCFG APR 3 '57 9a 470
 MCF + 27 Gwph 56/2168-82
 9a 481 MCFG + 27 Gwph 11
 9a 133 MCFG + 3.9 Gwph
 15 9a 152 MCFG + 15 Gwph
 ST PKR (~~2197~~ + ~~2218~~ @ 2191
 TO 2218 (PT 2202-17) 9a 470
 MCFG + 27 Gwph 12 9a
 3 Mill CFA w/spray wt 9a
 2,310 MCF + 120 Gwph Pooled
 ST PKR APR 10 '57 9a 3,249 MCFG
 + 135 Gswph 9a 3,200 MCFG
 + 3 Bwph 509 All perm.
 -PF APR 17 '57 CO APR 24 '57 CO 5299
 T69 w/PKR to 5216 9a 12,789
 MCFG for 5 hrs SIP 1050
 MAY 1 '57 PEPL + ST TP 1063 #
 Ab op F/W 29,800 MCFG pd.
 MAY 8 '57 complete ↑
 27-32-41 C SE/4

County Morton Elev. _____
 Sec. 27 Twp. 32 Rge. 41W
 Company Vickers Pet.
 Farm Name Bawker Gas unit No. 1

TOPS	DEPTH	LOG	DATUM	Loc. in Sec.
Anh.				C SE/4
Tr.				
H.				
Dg.				
BL.				
L.				Geol.
K.C.				Contr.
B.K.C.				Nye & Snell
Ce.				Pool
C.				Richfield
M.				
M.				
K.				
Mz.				
Mq.				
V.				
S.				
S.				
A.				
R.				
PE.				
G.				
T.D.				

Date Comm. 12-18-56

Vickers 50%, Stanolind 25%, Champlin 25%

R U R

~~34~~