

36

32


KANSAS 41 W

Section _____ Township _____ Range _____

1 Krey

Well No. _____

Company Kansas-Nebraska

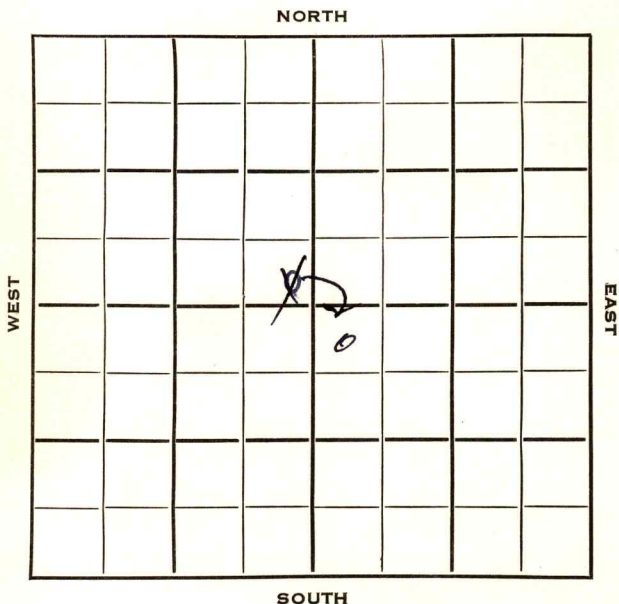

Morton

KANSAS ✓

Sec. 36 Twp. 32 R. 41WWell No. #1 Krey FarmKansas-Nebraska

Company

Contractor


Hugoton Pool

200 Ft. from N. Line~~200~~ Ft. from S. Line~~200~~ Ft. from E. Line200 Ft. from W. Line

NW SE

~~SE NW~~

Vickers F/O

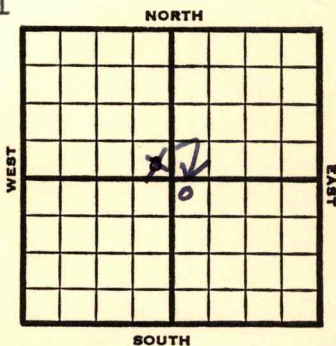

1953

Elev. 3388' REPORT

7/1 10" @ 341'

7/8 7" @ 2294 RTD 2298

7/22 Her 2182, Kr. 2203, Win 2246
 CO 102/ 2182-99 132/ 2202-24
 180/ 2246-76 frac.

7/29 NR
 8/5 "

8/26 "

10/7 Spud 6-23-53
 Gas well TD 2298' 10" @ 341
 7" @ 2294 TD 2298' Her. 2182'
 Kri. 2203' Win. 2246'
 CO to 2298 102/2182-99
 132/2202-24 180/2246-76 frac.
 Comp. 10,070,000 gas.

COMPLETED

Kansas

Map No. _____ Sec. 36 Twp. 32 R. 41WWell No. 1 Krey

Kansas-Nebraska

Company

CORRECTION

Contractor


NW SE

SECTION PLAT

200 Ft. from N. Line

_____ Ft. from S. Line

_____ Ft. from E. Line

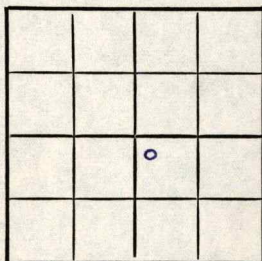200 Ft. from W. Line

Morton County

Location _____

Rig up _____

Drilling and Remarks:

Reported
SE NW

RECORD

Cased _____ in., _____ ft.

Sand _____

Gas _____

Oil _____

Total Depth _____

PRODUCTION

1st 24 hrs. Nat. _____

1st 24 hrs. after shot _____

Gas _____ Cu. Ft.

Dry Hole _____

Abandoned _____

Date

OCT 14 1919

J. G. McGEHEE

Scout

