

Morton

KANSAS

SECTION 36 TOWNSHIP 32 RANGE 41W

WELL NO. #1 Krey "A"

COMPANY Vickers Petr.


NORTH

C NW/4

SOUTH

WEST

EAST

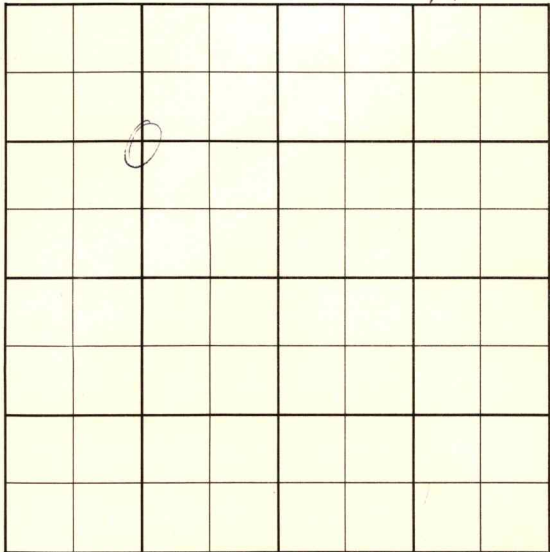

County Morton Elev. _____
 Sec. 36 Twp. 32 Rge. 41W
 Company Vickers Pet.
 Farm Name Krey "A" No. 1

TOPS	DEPTH	LOG	DATUM	Loc. in Sec.
Anh.				C NW/4
TP.				50' W
H.				
Tr.				
Dg.				
BL.				
L.				Geol. _____
K.C.				Contr. _____
B.K.C.				Nye & Snell
Ce.				Pool
C.				Richfield
M.				
M.				
K.				
Mz.				
Me.				
V.				
S.				
S.				
A.				
R.				
Pe.				
G.				
T.D.				

Date Comm. 1-16-57
9" @ 1390/1375 drlg. 1522

~~34~~

County Morton Elev. 3406
 Sec. 36 Twp. 32 Rge. 11W
 Company Tickers Pet.
 Farm Name Kroy "A" No. 1

TOPS	DEPTH	LOG	DATUM	Loc. in Sec.
Anh. <u>W26</u>	<u>2905</u>			<u>C NW 1/4</u>
TP.	<u>3146</u>	<u>3145</u>		
H. <u>Des Moines</u>	<u>4285</u>			<u>50' W</u>
Tr.				
Dg.				
BL.				
L.				
K.C.				Geol. _____
B.K.C.				Contr. _____
Ce.				
C. <u>Muskegon</u>	<u>4820</u>	<u>4809</u>		<u>Nye & Snell</u>
M. <u>" sd</u>		<u>5095</u>		
M. <u>" sd</u>		<u>5177-98</u>		Pool
K. <u>Keyes</u>		<u>5250-76</u>		<u>Richfield</u>
M. <u>chest</u>		<u>5276</u>		
M. <u>st Gen</u>		<u>5274</u>		
V.				
S.				
S.				
A.				
R.				
PE.				
G.				
T.D.	<u>5316</u>			

JUN 19 '57

COMPLETE

Date Comm. 1-16-57

9" @ 1390/1375 drl. 1522 JAN 30 '57

DST 3169-3205 48 90" 500'

GPR run 200' VSECM FFO-90

BHP 410/30" ID FEB 6 '57 ID 4836

FEB 13 '57 DST 4800-5010 1hr 250'

Md FFO 230-255 BHP 1055/30"

DST 5120-70 2 hrs 13:20' SW

+90' MSW BHP 1215/30" DST

5173-5225 1hr 230' GCM +

BHP 1380/30" DST 5225-53
1hr G/2" ga 2.530 MCF/5"
ga 3.350 MCF/60" net 358'
acm + 5' Free dist. BHP

1300/30" DST 5262-67 1hr
G/2" ga 4.260 MCF/45"
ga 4.160 MCF/60" net 2'
cond. + 58' Mud + 200' SW

BHP 1300/30" 7" @ 5316/1250
WOC FEB 20 '57 WOC FEB 27 '57 MAR 6 '57

CO 5280 APR 13 '57 CO 5285 96/5178-90

Ga 2,310 MCF 16 hrs net

G 2,580 MCF SKIP 1000"

SF 15/15 G 7,011 MCF in 50 hrs

SIP 1100⁰ MAR 20 '57 Pan East. ga

absol. of Flow 6.450 MCFG

Deliv. tst 4.300 MCFG

SIP 1075# T69 w/PRV to

5203 48/5250-56 ga 3.672

MCFG SIT 1064 Absol. of

Flow 3.710 MCFGPD

Keyes 2n 5250-60 ga 3.672

MUSD 5128-90 ga 10.397

MCFG MAR 27 '57 ✓ APR 3 '57 ✓ APR 10 '57 ✓

APR 17 '57 APR 24 '57 MAY 1 '57 MAY 15 '57 ~~The Return?~~

MAY 15 '57 MAY 22 '57 MAY 29 '57 JUN 5 '57 JUN 12 '57 JUN 19 '57

deliv. tst ga 2 Mill CFC
(both 2n's)