

Morton


KANSAS

SECTION 1 TOWNSHIP 32 RANGE 42W

WELL NO. #1 Maguire *Bughman*

COMPANY Graham-Michaelis

NORTH

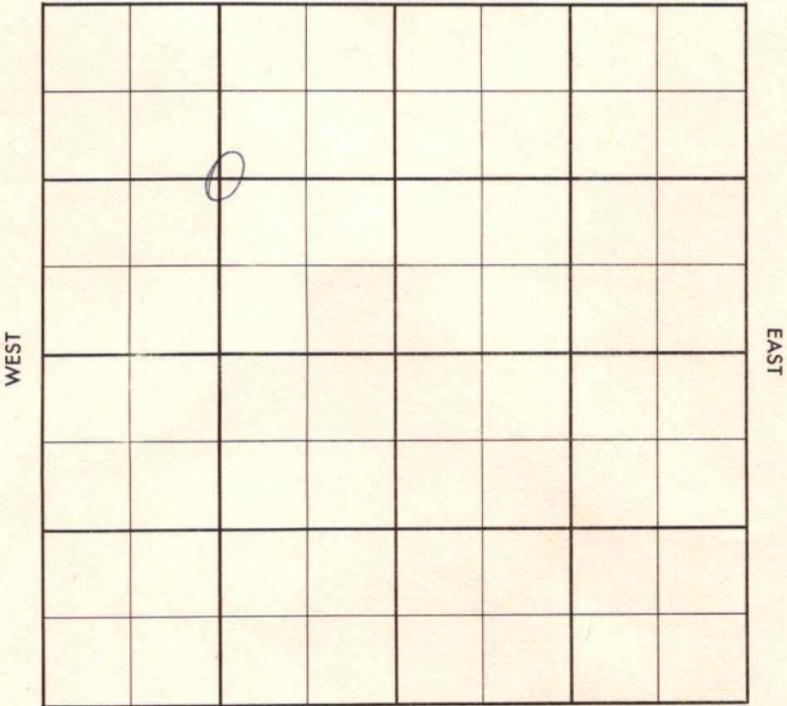

SOUTH

**CORRECTION**

County Morton Elev. 3460  
 Sec. 1 Twp. 32 Rge. 42W  
 Company Graham-Michaelis  
 Farm Name Nequiro-Baughman No. 1

TOPS	DEPTH	LOG	DATUM	Loc. in Sec.
Anh. <u>W30</u>		<u>2827</u>		<u>C NW/4</u>
TP. <u>E177</u>		<u>3076</u>		
H. <u>TP</u>		<u>3246</u>		
Tr.				
Dg.				
Bl.				
L.				Geol.
K.C.				Contr.
B.K.C.				
Ce.				
C.				
M.				Pool
M.				<u>Greenwood</u>
K.				
Mz.				
Ma.				
V.				
S.				
S.				
A.				
R.				
Pe.				
G.				
TD.	<u>3300</u>			



Date Comm. SUP. F.I.D.  
Cellar & pits. JAN 23 57 1-15-57  
8 7/8 @ 357/300 ID # 2732 JAN 30 57  
5 1/2 @ 3277/100 WOC FEB 6 57 PF  
3204-08 PF 3188-92 PF  
3172-78 PF 3142-48 PF  
9a 700 MCFG 9a 700  
MCFG 16 9a 750 MCFG FEB 13 57  
119 @ 3095 PF 3030-34  
PF 3042-48 3059-62

Co.  
Lse.  
No.  
Sec.  
T.  
R.

3078-84  $\Delta$  no gas PB  
 2945 PF 2890-93 2902-05  
 2913-17 2920-24 2934-38  
 $\Delta$  no gas  $\Phi$  70 6 SWPH  
 (50d ~~to~~ PFS 2890-2938)  
 PF 2862-65 2856-60 2842  
 -45 2833-38 2821-24  $\Delta$   
 FEB 20 '57 T5M CO 3215 ST PK  
 Lower set 3142-3208  $\Delta$   
 channelled ga 600 MCFG  
 (wet) water decreasing. FEB 27 '57 ✓  
 MAR 6 '57 72-20 ga 5 Mill.  
 CFG. RP 425#

County Morton Elev. 3460  
 Sec. 1 Twp. 32 Rge. 12W  
 Company Graham-Michaelis  
 Farm Name Maguire No. 1

TOPS	DEPTH	LOG	DATUM
Anh.			
TP.			
H.			
Tr.			
Dg.			
BL.			
L.			
K.C.			
B.K.C.			
Ce.			
C.			
M.			
M.			
K.			
Mz.			
Me.			
V.			
S.			
S.			
A.			
R.			
PE.			
G.			
T.D.			

Loc. in Sec. C NW/4  
 Geol. \_\_\_\_\_  
 Contr. \_\_\_\_\_  
 Pool Greenwood

FIRST REPORT		
JAN 16 1957		

Date Comm. Cellar & pits

34

Co. Lse. No. Sec. T. R.