DX 78-1


Morton

KANSAS

Section 2 Township 32 Range 42W

Well No. 1 Lunt

Company Colorado O&G

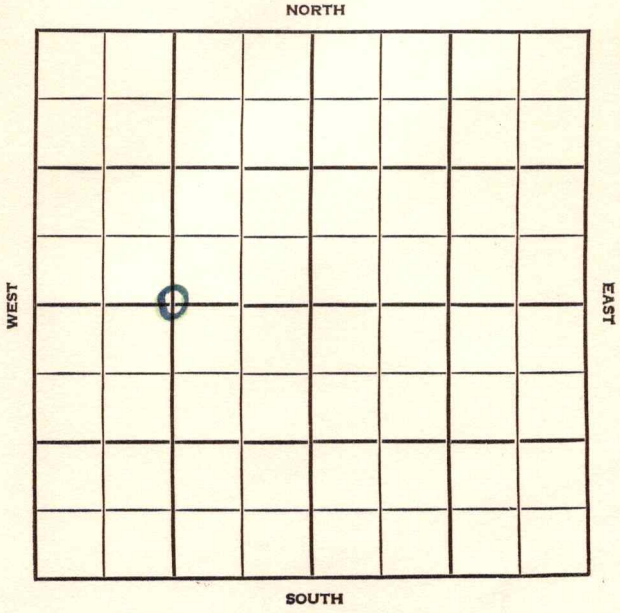

Morton KANSAS


SEC.	TWP.	R.
2	32	42W

WELL NO.
1 Lunt FARM

COMPANY
Colorado O & G

CONTRACTOR
Honaker

Greenwood

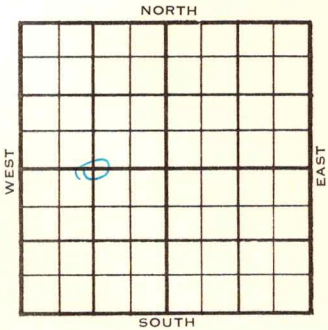

_____ Ft. from N. Line

_____ Ft. from S. Line

_____ Ft. from E. Line

_____ Ft. from W. Line

C W½ Sec.

1955	ELEVATION REPORT
6/29	Comm 6-11-55 8" @ 613/400 DST 2796-2849 open 45 min. gas in 1½ min. 2000 mcfg Rec 110' gcm 468/30" DST 2944-3026 open 2 hr Rec 100' gcm 450# DST 3208-18 open 2 hr Rec 40' gcswcm 60' swcm 50' sw 340/30" TD 3375 5" @ 3217/400 CO to 3187 perf/3161-70 3141-43 3131-34 3100-07 300 A 675 mcfg 20 g wph PB 3070 perf/3029-49 3004-12 2990-92 2979-83 955 mcfg 7000 A 890 mcfg 17 gwph 2000 A 750 mcfg 7½ gwph CO to 3187 1305 mcfg 15 gwph tstg.
7/13	15 gwph SP 2830 16/2862-66, 12/2881-8[illegible] 8/2901-03, 2000A 822 mcfg 30 gwph SP 2854 perf/2816-31, 2804-06 4000A 4,147 mcfg 20 gwph CO to 3187 5,820 mcfg Comp 9,150 mcfgpd 450#

Tops	Log
H. Waub	2789
Tr.Elment	3029
Dg top	3203
BL lecomp	3335

COMPLETED

DX-78

FORM 513 REV. SUNRAY

County Morton Elev.

Sec. 2 Twp. 32 Rge. 42W

Company Colorado O & G

Farm Name Lunt No. 1

TOPS	DEPTH	LOG	DATUM
Anh.			
Tp.			
H.			
Tr.			
Dg.			
B.L.			
L.			
K.C.			
B.K.C.			
Ce.			
C.			
M.			
M.			
K.			
Mz.			
Mc.			
V.			
S.			
S.			
A			
R.			
P€.			
G.			
T.D.			

Loc. in Sec. C W½ Sec.

Geol.

Contr. Honaker

Pool Greenwood

FIRST REPORT


JUN 29 55

Date Comm. 6-11-55

8" @ 613/400 DST 2796-2849 open 45 min gas in 1½ min. 2000 mcfg Rec. 110' gcm 468/30" DST 2944-3026 open 2 hr Rec. 100' gcm 450# DST 3208-18 open 2 hr. Rec. 40' gcswcm 60' swcm 50' sw 340/30" TD 3375 5" @ 3217/400 CO to 3187 perf/3161-70 3141-43

Co. Lse. No. Sec. T. R.

3131-34 3100-07 300 A 675 mcfg
20 gwph PB 3070 perf/ 3029-49
3004-12 2990-92 2979-83 955 mcfg
7000 A 890 mcfg 17 gwph 2000 A
750 mcfg 7½ gwph CO to 3187 1305 mcfg
15 gwph t stg.

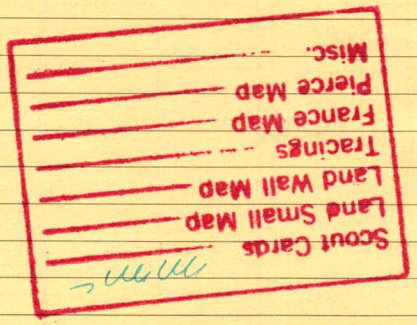

JUL 1 1955

FORM 513 REV. SUNRAY

County Morton Elev.

Sec. 2 Twp. 32 Rge. 42W

Company Colorado O & G

Farm Name Lunt No. 1

TOPS	DEPTH	LOG	DATUM
Anh.			
Tp.			
H. Wawb		2789	
Tr. Lansing		3029	
Dg. Top		3203	
B.L. Base Comp		3335	
L.			
K.C.			
B.K.C.			
Ce.			
C.			
M.			
M.			
K.			
Mz.			
Mo.			
V.			
S.			
S.			
A			
R.			
P€.			
G.			
T.D.	3375		

Loc. in Sec. C W½ Sec.

Geol.

Contr. Honaker

Pool Greenwood

COMPLETE

Date Comm. 6-11-55 JUL 13 1955

8" @ 613/400 DST 2796-2849 open 45 min gas in 1½ min. 2000 mcfg Rec. 110' gcm 468/30" DST 2944-3026 open 2 hr. Rec. 100' gcm 450# DST 3208-18 open 2 hr. Rec. 40' gcswcm 60' swcm 50' sw 340/30" TD 3375 5" @ 3217 CO to 3187 perf/ 3161-70 3141-43

OVER

Co. Lse. No. Sec. T. R.

3131-34 3100-07 300 A 675 mcfg
20 gwph PB 3070 perf. 3029-49
3004-12 2990-92 2979-83 955 mcfg
7000 A 800 mcfg 17 gwph 2000 A
750 mcfg 7½ gwph CO to 3187 1305 mcfg
15 gwph SP 2930 16/ 2862-66
12/ 2881-84 8/ 2901-03 2000 A
822 mcfg 30 gwph CO to 3187
1,167 mcfg 30 gwph SP 2854 perf/ 2816-
31 2804-06 4000 A 4,147 mcfg 20 gwph
CO to 3187 5,820 mcfg
Comp. 9,150 mcfgpd 450#

