

Morton


KANSAS

SECTION 6 TOWNSHIP 32 RANGE 142 W

WELL NO. #1 Smith "S"

COMPANY Cities Service

NORTH

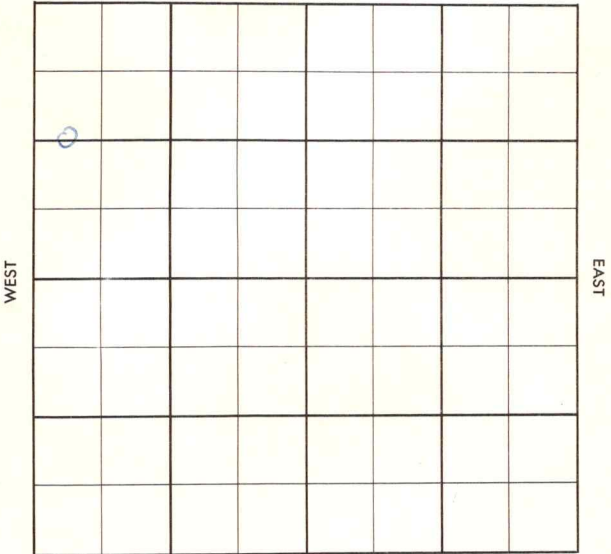

SOUTH

Morton

KANSAS

SEC.	TWP.	R.
6	32	42W

WELL NO.

#1 Smith "S"

FARM

COMPANY

Cities Service

CONTRACTOR

Holm Drlg.


Greenwood

1340 Ft. from N. Line

Ft. from S. Line

Ft. from E. Line

100 Ft. from W. Line

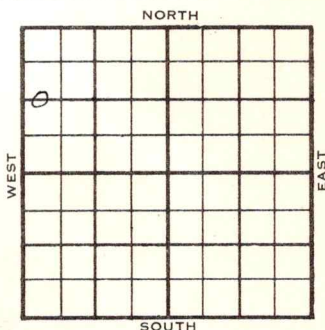C $W\frac{1}{2}$ $W\frac{1}{2}$ NW


	ELEVATION	REPORT
1955	3551	
12-14	Comm. 12-5-55 8" @ 600/450 Drlg. 3030	
1956		
1-25	5 $\frac{1}{2}$ " @ 3242/250 CO to 3193, 120/ 3140-70, 4000 A 4,290 mcfgpd, SP 3120, 52/ 3084-97 40/ 3046-56, 3000 A Co to 3193, 4,950 mcfg, SP 3020 80/ 2972-92, 2000 A, 600 gswph, CO to 3190, Reperf 120/3140-70, 2000 A, 5000 A Comp. 12,900 mcfgpd, 422# Neva 2734 Tp. 2968 L. 3268 TD 3250'	

COMPLETED

County Morton Elev. 42W
 Sec. 6 Twp. 32 Rge. 42W
 Company Cities Service
 Farm Name Smith No. 1

TOPS	DEPTH	LOG	DATUM	Loc. in Sec.
Anh.				C W $\frac{1}{2}$ W $\frac{1}{2}$ NW
Tp.				1340 NL
H.				100' WL
Tr.				
Dg.				
Bl.				
L.				Geol.
K.C.				Contr.
B.K.C.				Holm Drlg.
Ce.				
C.				Pool
M.				Greenwood
M.				
K.				
Mz.				
Me.				
V.				
S.				
S.				
A.				
R.				
Pe.				
G.				
T.D.				

Date Comm. 12-5-55
8" @ 600/450 drlg. 3030

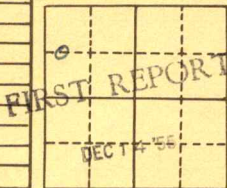

54

County Morton Elev. 3551
 Sec. 6 Twp. 32 Rge. 42W
 Company Cities Service
 Farm Name Smith "S" No. 1

TOPS	DEPTH	LOG	DATUM	Loc. in Sec.
Anh. <u>Neva</u>		<u>27.34</u>		C W $\frac{1}{2}$ W $\frac{1}{2}$ NW
Tp.	<u>2968</u>			1340' NL
H.				100' WL
Tr.				
Dg.				
Bl.				
L.		<u>3268</u>		Geol.
K.C.				Contr.
B.K.C.				Holm Drlg.
Ce.				Pool
C.				Greenwood
M.				
M.				
K.				
Mz.				
Me.				
V.				
S.				
S.				
A.				
R.				
Pe.				
G.				
T.D.	<u>3250</u>			

COMPLETE

Date Comm. 12-5-55 JAN 2 5 1956

8" @ 600/450 5 $\frac{1}{2}$ " @ 3242/250

CO to 3193 120/ 3140-70 4000 A

4,290 mcfgpd SP 3120 52/ 3084-97

40/ 3046-56 3000 A CO to 3193

4,950 mcfg SP 3020 80/ 2972-92

2000 A 600 gswph CO to 3190

reperf 120/3140-70 2000 A 5000 A

Comp. 12,900 mcfgpd 422#