

Morton


DX 78-1

KANSAS

Section 6 Township 32 Range 42W

Well No. #1 Taylor

Company Colorado Oil & Gas

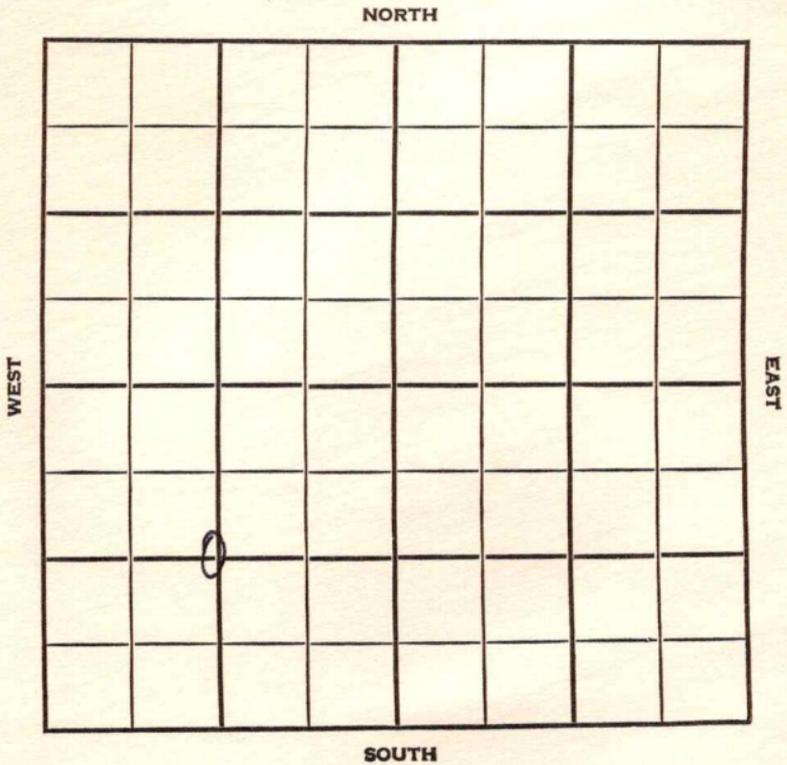

Morton KANSAS


SEC. 6 TWP. 32 R. 42W

WELL NO. 1 Taylor FARM

COMPANY Colorado Oil & Gas

CONTRACTOR Holm Drlg.  
Wildcat

\_\_\_\_\_ Ft. from N. Line  
1320 \_\_\_\_\_ Ft. from S. Line  
\_\_\_\_\_ Ft. from E. Line  
1320 \_\_\_\_\_ Ft. from W. Line

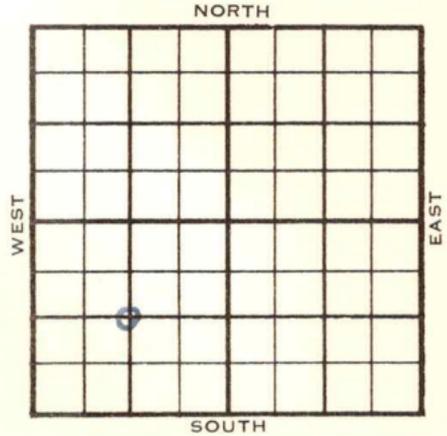

C SW/4

	ELEVATION	REPORT
1955	2548'	

3/9	Spud 3-4-55 8" @ 612', WOC	
4/6	Spud 3-4-55 - Gas Well TD 3311' 8" @ 612' Waub. 2735', Elm 2960', Top 3133', LeCompton 3256' DST 2736-90', opn 2 hrs., rec. 90' gcm, 550# DST 3264-77', opn 1½ hrs., gas in 2", 240,000 cfg, 5", 60' gcm, 900' SW O# TD 3311' 5" @ 3228' CO to 3199' 16/3158-72, 28/3148-55, 24/3136-42, 6000A 7,728,000 cfg, SP 3120 20/3042-47, 20/3068-73, 36/3082-91', 12/3097-3100, 4000A 536,000 cfg, SP 3000, 76/2963-82', 275,000 cfg, 4 gwph, 3000A 2,797,000 cfg, 25 gwph, 14,100,000 cfg, SP 2810, 28/2769-76, 8/2756-58, 4 gwph, 1500A, 30 gwph	

(Information Brought Forward)

1955  
4/6

CO to 3195'

14,936,000 cfg

10,493,000 cfg

Comp. 19,300,000 cfgpd,419#

**COMPLETED**


County **Morton** State **Kansas**

Sec. **6** (Blk. Twp.) **32** (Sur. Rge.) **42W** Map No.

Operator **Colorado Oil & Gas**

Well No. **1** Farm **Taylor**

Elev. Location **C SW/4**

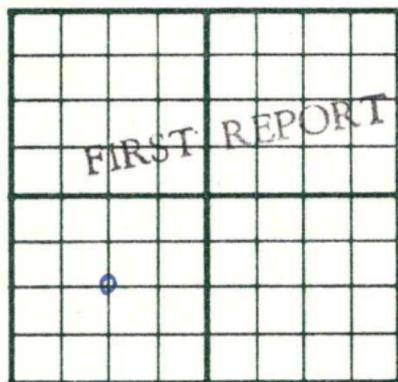

**1320**ft. From **S** Line **SW**

**1320**ft. From **W** Line **Quarter**

1st. Report **MAR 9 1955**

Completion

Remarks

**Holm Drlg. - Contr.**

Spudding Date **3-4-55**

Drlg. Data **Wildcat**

**8" @ 612 WOC**

FABEN GILSTRAP

MAR 14 1955

Scout Cards	<u>10</u>
Land Small Map	
Land Wall Map	
Tracings	<u>3</u>
France Map	
Pierce Map	
MISC.	

Orig. Data

County Morton State Kansas  
 Sec. 6 (Blk. 32) (Sur. 42W) (Twp.) (Rge.) Map No.  
 Operator Colorado Oil & Gas  
 Well No. 1 Farm Taylor  
 Elev. 3548 Location C SW/4


1320Ft. From S Line SW  
1320Ft. From W Line Quarter  
 1st. Report \_\_\_\_\_  
 Completion APR 6 1955  
 Remarks \_\_\_\_\_  
Holm Drlg. - Contr.  
 Spudding Date 3-4-55

Drlg. Data Gas well TD 3311  
8" @ 612 Waub. 2735 Elm 2960  
Top. 3133 LeCompton 3256 DST 2736-90  
open 2 hr. Rec. 90' gcm 550#  
DST 3264-77 open 1 1/2 hr. gas in 2 min.  
240,000 cfg 5 min. 60' gcm 900' sw  
0# TD 3311 5" @ 3228 CO to 3199  
16/ 3158-72 28/ 3148-55 24/ 3136-42  
6000 A 7,728,000 cfg SP 3120  
20/ 3042-47 20/ 3068-73 36/ 3082-91  
12/ 3097-3100 4000 A 536,000 cfg  
SP 3000 76/ 2963-82 275,000 cfg 4 gwph  
3000 A 2,797,000 cfg 25 gwph  
14,100,000 cfg SP 2810 28/ 2769-76  
8/ 2756-58 4 gwph 1500 A 30 gwph

FABEN GILSTRAP

Drig. Data

CO to 3195 14,936,000 cfg 10,493,000 cfg

Comp. 19,300,000 cfgpd 419#

Scout Cards	
Land Small Men	
Land Wall Map	
Tracing	
France Map	
Piece Map	
Misc.	

*Handwritten signature and a circled '3' are present in the box.*

APR 14 1955