


Section 19 Township 32 Range 42W

Well No. #1 Stoops

Company Colorado Oil & Gas

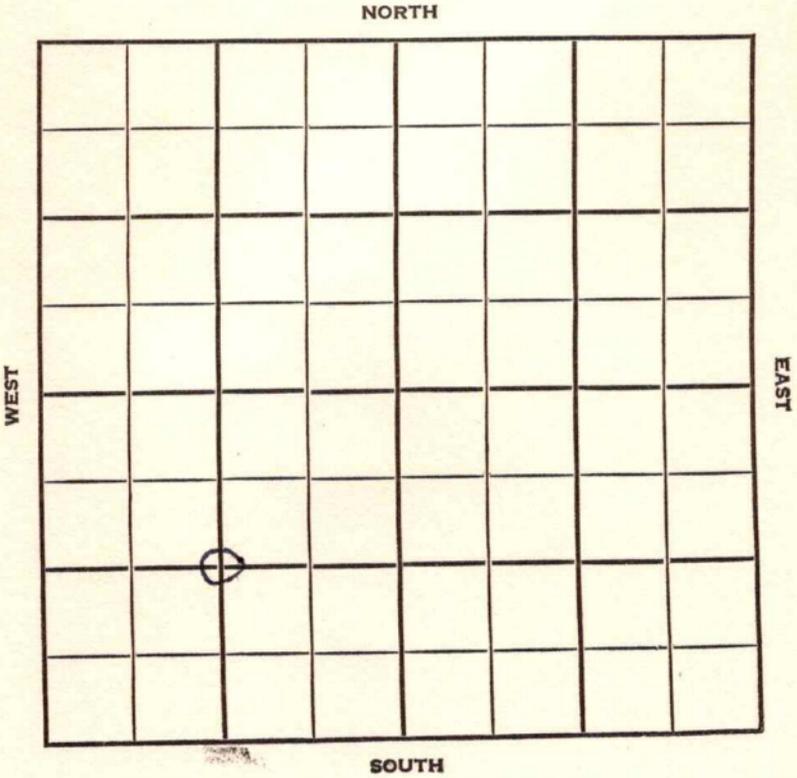

Morton KANSAS

SEC.	TWP.	R.
19	32	42W

WELL NO. 1 Stoops FARM

COMPANY Colorado O&G

CONTRACTOR Holm Drlg.


Greenwood Pool

\_\_\_\_\_ Ft. from N. Line

1320 \_\_\_\_\_ Ft. from S. Line

\_\_\_\_\_ Ft. from E. Line

1320 \_\_\_\_\_ Ft. from W. Line

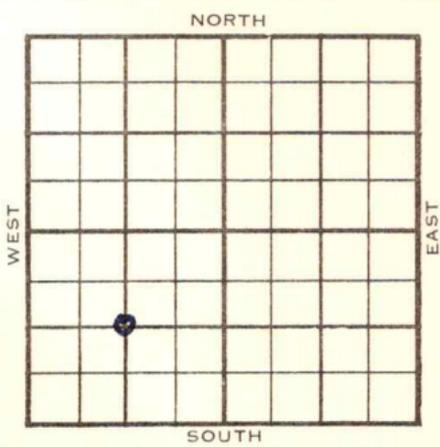

C SW/4

1955	ELEVATION 3560'	REPORT
------	--------------------	--------

4/13 Spud 4-7-55  
8" @ 634'  
rlg. 2440'

County Morton State Kansas

Sec. 19 (Blk. 32 (Sur. 42W (Twp.) Rge.) Map No.

Operator Colorado Oil & Gas

Well No. 1 Farm Stoops

Elev. 3560 Location C SW/4



1320 Ft. From S Line SW

1320 Ft. From W Line Quarter

Ist. Report APR 13 1955

Completion \_\_\_\_\_

Remarks \_\_\_\_\_

Holm Drlg. - Contr.

Spudding Date 4-7-55

Drlg. Data Greenwood Pool

8" @ 634 drlg. 2440

FABEN GILSTRAP