


Section 22 Township 32 Range 42 W

Well No. # 1 Bender

Company Colorado Oil & Gas

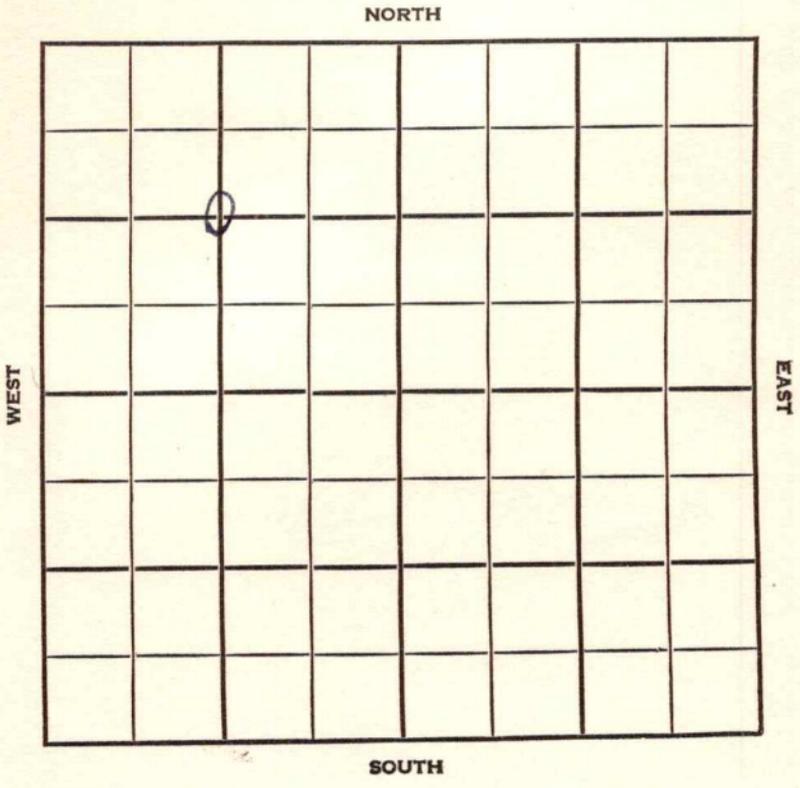

Morton KANSAS


SEC.	TWP.	R.
22	32	42W

WELL NO. 1 B^Bender FARM

COMPANY Colorado Oil & Gas

CONTRACTOR Greenwood Pool

1320 Ft. from N. Line
 Ft. from S. Line
 Ft. from E. Line
 1320 Ft. from W. Line

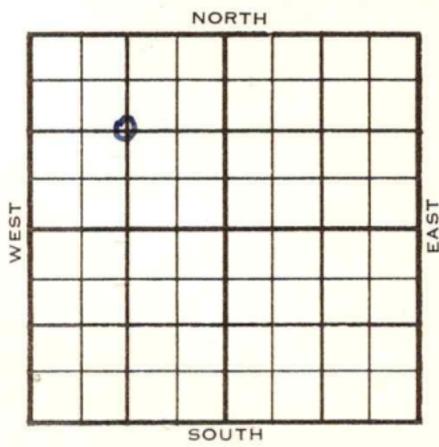

C NW/4

1954	ELEVATION 3509'	REPORT
------	--------------------	--------

11/10 Spud 11-6-54
 8" @ 641'
 TD 647'

1955
 2/23 Spud 11-6-54 Gas well TD 4253'
 8" @ 641' Waub. 2778 Elmont 3016'
 Top. 3168 Lans. 3533 LeCompton 3298
 Compton 4000' TD 4253' 5" @ 4251
 DST 2806-21 open 2 hr rec 90' GCM
 480#
 DST 2843-2905 open 2 hr rec 90' SGCM
 325#. DST 3322-47 open 2 hr,
 rec 360' SW & M 525#
 DST 3504-20 open 2 hr rec 9' mud
 1240# DST 3532-50 open 2 hr rec 25'
 mud. 485#
 DST 4196-4216 open 2 hr rec 120' mud
 CO 40/3790-3800 56/4195-4209
 2500 A 40 GWPB PB 3595 36/3531-40
 1500 A 70 GWPB CO to 3523
 48/3298-3310 1800 A 1,300,000 CFG
 100 GWPB 48/3252-64 300,000 CFG
 70 GWPB SP 3235 76/3186-3205
 20/3177-82 28/3165-72 6500A
 4,000,000 CFG 15 GWPB SP 3150
 36/3121-30 2000 A 5,200,000 CFG

OVER

1955
2/23

(Information continued)

30 GWPH TD 4258 DP to 4258

8,000,000 CFG 175 GWPH

6,110,000 CFG 40 GWPH SP 4114

48/3090-3102 32/3064-72 20/3052-57

5000 A 410,000 CFG 35 GWPH

SP 4258 6,258,000 CFG 35 GWPH

SP 3044 32/3014-22 1500 A

5,598,000 CFG 65 GWPH DP to 3044

7,534,000 CFG 65 GWPH SP 3008

24/2988-94 20/2965-70 2000 A

5,500,000 CFG 55 GWPH SP 2950

24/2898-2904 1000 A CO to 2882

44/2841-52 32/2810-18 3000 A

133,000 CFG 80 GWPH 20/2787-92

1000 A wtr. CO to 3274'

8,860,000 CFG

Comp. 14,780,000 CFGPD 420#

COMPLETED

County Morton State Kansas
 Sec. 22 (Blk. 32 (Sur. 42W Map No.)
 (Twp.) (Rge.)
 Operator Colorado Oil & Gas
 Well No. 1 Farm Bender
 Elev. 3509 Location C NW/4



1320Ft. From N Line NW
1320Ft. From W Line Quarter

1st. Report

Completion FEB 23 1955

Remarks Greenwood Pool

Spudding Date 11-6-54

Drlg. Data Gas well TD 4253

8" @ 641 Waub. 2778 Elmont 3016

Top. 3168 Lans. 3533 LeCompton 3298

Compton 4000 TD 4253 5" @ 4251

DST 2806-21 open 2 hr. Rec. 90' gcm

480# DST 2843-2905 open 2 hr. Rec.

90' sgcm 325# DST 3322-47 open 2 hr.

Rec. 360' sw & m 525# DST 3504-20

open 2 hr. Rec. 9' mud 1240#

DST 3532-50 open 2 hr. Rec. 25' mud

485# DST 4196-4216 open 2 hr.

Rec. 120' mud CO 40/ 3790-3800

56/ 4195-4209 2500 A 40 gwph

PB 3595 36/ 3531-40 1500 A 70 gwph

CO to 3523 48/ 3298-3310 1800 A

OVER

FABEN GILSTRAP

Drlg. Data

~~1,300,000 cfg 100 gwph 48/ 3252-64~~
~~300,000 cfg 70 gwph SP 3255 W 076/ 3186-~~
~~3205 20/ 3177-82 28/ 3165-72~~
~~6500 A 4,000,000 cfg 15 gwph SP 3150~~
~~36/ 3121-30 2000 A 5,200,000 cfg~~
~~30 gwph 2 4258 DP to 4258~~
 8,000,000 cfg 175 gwph 6,110,000 cfg
 40 gwph SP 4114 48/ 3090-3102
 32/ 3064-72 20/ 3052-57 5000 A
 410,000 cfg 35 gwph SP 4258
 6,258,000 cfg 35 gwph SP 3044
 32/ 3014-22 1500 A 5,598,000 cfg
 65 gwph DP to 3044 7,534,000 cfg
 65 gwph SP 3008 24/ 2988-94
 20/ 2965-70 2000 A 5,500,000 cfg
 55 gwph SP 2950 24/ 2898-2904
 1000 A CO to 2882 44/ 2841-52
 32/ 2810-18 3000 A 133,000 cfg
 80 gwph 20/ 2787-92 1000 A wtr.
 CO to 3274 8,860,000 cfg
 Comp. 14,780,000 cfgpd 420#

