

Morton

**KANSAS**

24


32

42W

SECTION \_\_\_\_\_ TOWNSHIP \_\_\_\_\_ RANGE \_\_\_\_\_

WELL NO. #1 Stucky "A"

COMPANY Excelsior Oil Co.

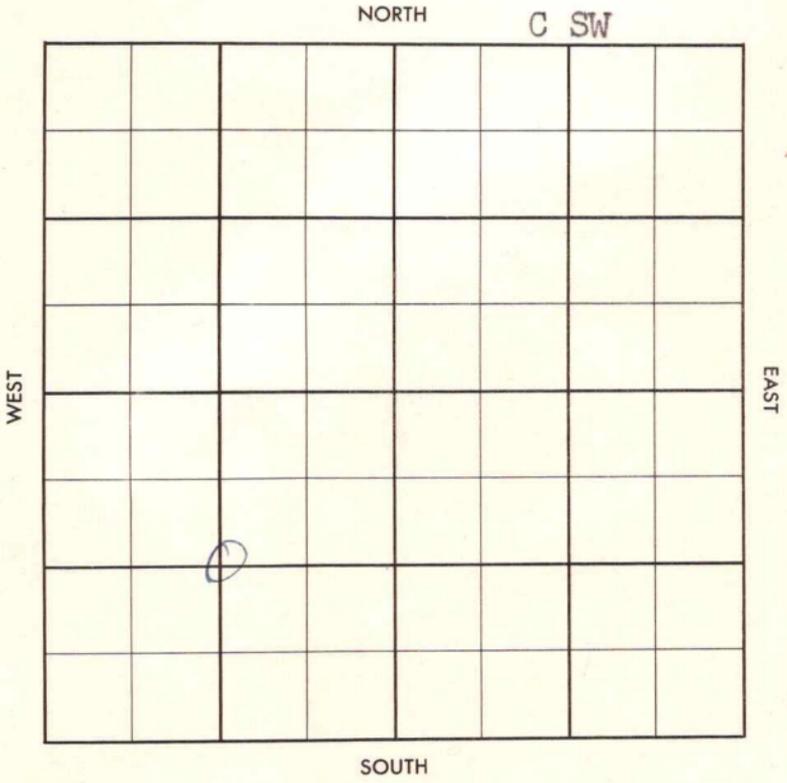

County Morton Elev. \_\_\_\_\_  
 Sec. 24 Twp. 32 Rgs. 42W  
 Company Excelsior Oil Co.  
 Farm Name Stucky "A" No. 1

TOPS	DEPTH	LOG	DATUM	Loc. in Sec.
Anh.				C SW
Tp.				
H.				
Tr.				
Dg.				
Bl.				
L.				Geol. _____
K.C.				Contr. _____
B.K.C.				Honaker-Davis
Ce.				
C.				Pool
M.				Greenwood
M.				
K.				
Mz.				
Mq.				
V.				
S.				
S.				
A				
R.				
Pe.				
G.				
T.D.				

FIRST REPORT	
APR 10 '57	

Date Comm. Colorado Oil & Gas (FO)  
 Location \_\_\_\_\_

~~34~~

Co.  
L.S.  
No.  
Sec.  
T.  
R.

County Morton Elev. 3483  
 Sec. 24 Twp. 32 Rge. 42W  
 Company Excelsior Oil Co.  
 Farm Name Stucky "A" No. 1

TOPS	DEPTH	LOG	DATUM	Loc. in Sec.
Anh. <u>Wd 0</u>		<u>2840</u>		<u>C SW</u>
Tp. <u>Elm</u>		<u>3090</u>		
H. <u>TP</u>		<u>3242</u>		
Tr.				
Dg.				
Bl.				
L.				Geol.
K.C.				
B.K.C.				Contr.
Ce.				<u>Honaker-Davis</u>
C.				
M.				Pool
M.				<u>Greenwood</u>
K.				
Mz.				
Me.				
V.				
S.				
S.				
A.				
R.				
PF.				
G.				
T.D.	<u>3246</u>			

JUN 26 '57  
**COMPLETE**

Date Comm. Colorado Oil & Gas (FO)  
 Location APR 17 '57 4-9-57 8578678  
1350 Rn 9 5 1/2 APR 24 '57 5 1/2 @  
3243/300 MAY 1 '57 MICT CO MAY 15 '57  
CO 3246 1/2 ga 945 MIF 6  
INC to 1.164 MIF p 19 @ 3225  
PF 3199-3210 3169-77 @  
3139-47 1/2 ga 1.750 MIF  
CO ~~3100~~ PB 3100 PF 3068-70  
A ga 1.730 MIF MAY 15 '57 36/

2900-09 8/2882-84 12/  
 2873-76 1/ 9a 75 MCFG  
 MAY 22 '57 CO 3246 9a 1,930 MCF  
 + 30 Gwph MAY 29 '57 JUN 5 '57 JUN 12 '57  
 JUN 19 '57 JUN 26 '57 72-20 9a  
 5,204 MCFG RP 424H