


Section 30 Township 32 Range 42W

Well No. 1 J. B. Smith "C" Unit

Company Texas Company

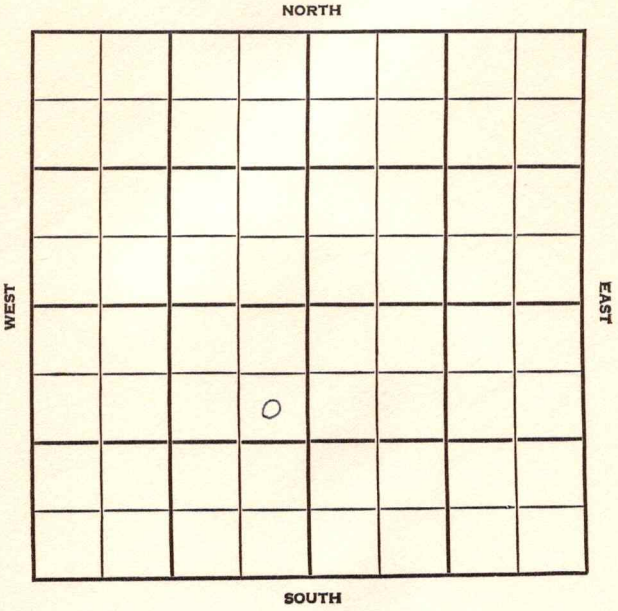

Morton KANSAS

SEC.	TWP.	R.
30	32	42W

WELL NO.

1 J. B. Smith "C" Unit

FARM

COMPANY

Texas Co.

CONTRACTOR

Walter Kuhn


Greenwood Gas Pool

1250 Ft. from N. Line

Ft. from S. Line

100 Ft. from E. Line

Ft. from W. Line

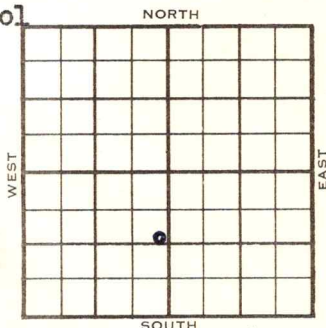

SE NE SW

ELEVATION

REPORT

1955

4/27

Spud 4-22-55

10" @ 694'

Drlg. 1365'

5/25

Top 2931; Lsg 3198

TD 3267; 10" 694; 7" 3266;

CO 3244; 40/3210-20; 1000A; swb 20

gwph 7 hrs plus 253,000 cfg; 24/3152-

56; 2,160,000 cfg; 12/3011-13;

24/3000-04; 18/2982-85; 24/2932-37

78/2901-14 3,770,000 cfg; 5000A

13,144,000 cfg; 19,600,000 cfg

COMPLETED

County Morton State Kansas

Sec. 30 (Blk. Twp.) 32 (Sur. Rge.) 42W Map No.

Operator Texas Company

Well No. **1** Farm **J. B. Smith "C" Unit**

Elev.	Location	SE	NE	SW

[illegible]

1250 Ft. From N Line SW

100 Ft. From E Line Quarter

1st. Report APR 27 1955

Completion _____

Remarks

Walter Kuhn - Conts,

Spudding Date 4-22-55

Drlg. Data Greenwood Gas Pool

10" @ 694 drlg. 1365

K-34

FABEN GILSTRAP