
DX 78-1

Morton KANSAS

Section 33 Township 32 Range 42 W

Well No. # 1 Murphy

Company Panhandle Eastern

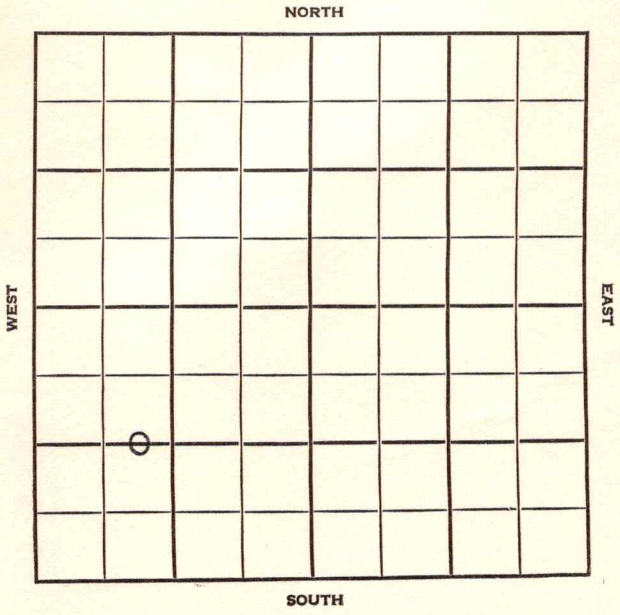

Morton KANSAS

SEC.	TWP.	R.
33	32	42W

WELL NO.

1 Murphy FARM


COMPANY

Panhandle Eastern

CONTRACTOR

Garvey

Greenwood Pool

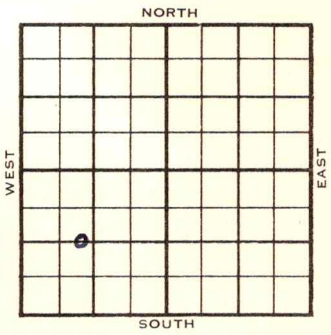

_____ Ft. from N. Line

1320 Ft. from S. Line

_____ Ft. from E. Line

1075 Ft. from W. Line

C E/2 W/2 SW

1955	ELEVATION 3493'	REPORT

2/2 Location

3/30 Spud 2-9-55 Gas well TD 3350
10" @ 609 28 GWPH SP 3315
4/3299-3300 500 A B/24 GSWPH
SP 3290 12/3274-76 17 GWPH
SP 3260 12/3245-47 SW SP 3240
12/3199-3201 460,000 CFG 11 GWPH
Perf /3201-08 40/3208-18 1000 A
2,482,000 CFG 8 GWPH 10 hr.
2,488,000 CFG SP 3193 48/3178-86
3,232,000 CFG 1 hr. 2,508,000 CFG 3
hrs. 25-30 GWPH 2,500,000 CFG 12 hr.
50 to 60 GWPH SP 3163 18/3199-3208
B/20 GWPH SSG 1000 A 500,000 CFG
HFW SP 3150 Perf 3199-3208 Co
32/3131-39 16/3117-21 400,000 CFG
1000 A 1,790,000 CFG 10 GWPH
2000 A 4,191,000 CFG
Comp. 18,861,000 CFGPD 419.1#

COMPLETED

DX-78

FORM 275 FOR SALE BY KANSAS BLUE PRINT CO.

County Morton State Kansas

Sec. 33 (Blk. Twp.) 32 (Sur. Rge.) 42W Map No.

Operator Panhandle Eastern

Well No. 1 Farm Murphy

Elev. Location C E½ W½ SW



1320 Ft. From S Line SW

1075 Ft. From W Line Quarter

1st. Report FEB 2 1955

Completion

Remarks

Garvey - Contr.

Spudding Date

Drlg. Data Greenwood Pool

Location

FABEN GILSTRAP

FORM 275 FOR SALE BY KANSAS BLUE PRINT CO.

County Morton State Kansas

Sec. 33 (Blk. / Twp.) 32 (Sur. / Rge.) 42W Map No.

Operator Panhandle Eastern

Well No. 1 Farm Murphy

Elev. 3493 Location C E½ W½ SW



1320 Ft. From S Line SW

1075 Ft. From W Line Quarter

1st. Report

Completion MAR 3 0 1955

Remarks Greenwood Pool
Garvey - Contr.

Spudding Date 2-9-55

Drlg. Data Gas well TD 3350

10" @ 609 TD 3350 7" @ 3343

4/ 3321-22 28 gwph SP 3315

4/ 3299-3300 500 A B/ 24 gswph

SP 3290 12/ 3274-76 17 gwph

SP 3260 12/ 3245-47 sw SP 3240

12/ 3199-3201 460,000 cfg 11 gwph

perf/ 3201-08 40/ 3208-18 1000 A

2,482,000 cfg 8 gwph 10 hr.

2,588,000 cfg SP 3193 48/ 3178-86

3,232,000 cfg 1 hr. 2,508,000 cfg 3 hr.

25 to 30 gwph 2,500,000 cfg 12 hr.

50 to 60 gwph SP 3163 18/ 3199-3208

B/ 20 gwph SSG 1000 A 500,000 cfg

HFW SP 3150 perf. 3199-3208 CO

FABEN GILSTRAP

OVER

Drlg. Data

32/ 3131-39 16/ 3117-21 400,000 cfg

1000 A 1,790,000 cfg 10 gwph/ 2000 A

4,191,000 cfg

Comp. 18,861,000 cfgpd 419.1#

Misc.
Pierce Map
Fidonce Map
Tracings
Land Wall Map
Land Small Map
Scout Cards
MAY 1 1955