


Section 34 Township 32 Range 42 W

Well No. # 1 *Neuerburg.*
~~Neuerberger~~

Company Colorado O & G

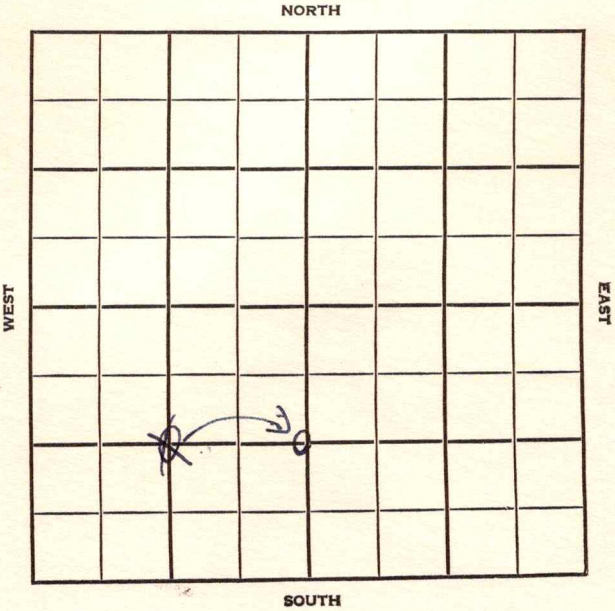

SEC.	TWP.	R.
34	32	42W

WELL NO. **NEUERBERG**
1 Neuerberger FARM

COMPANY
 Colorado O&G

CONTRACTOR
 Rocket Drlg.
 Greenwood Pool

Ft. from N. Line


1320 Ft. from S. Line

2600 Ft. from E. Line

1320 Ft. from W. Line

C E/2 E/2 SW

C SW/4

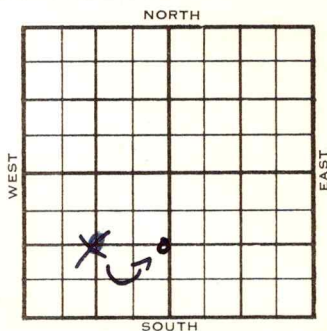

	ELEVATION	REPORT
1954	3490'	

11/10 RUR

1955

1/19

Spud 11-8-54 Gas well TD 3506
 8-5/8" @ 651 **Waubunsee 2714**
#1mont 2952 Top. 3093 LeCompton
3215 Lans 3438
 DST 2720-73 open 1 hr 1,660,000 CFG
 90' GCM 435#
 DST 2788-2859, open 2 hr.
 DST 2872-2955 open 2 hr rec 65' mud.
 35# DST 3384-3421 open 2 hr, rec
 20' mud. 510#
 DST 3452-70 open 2 hr rec 10' mud 0#
 TD 3506 5" @ 3501 CO to 3472
 48/3446-58 2000 A S/wtr. 16/3260-6L
 S/wtr. Perf 3247-53 1000 A wtr.
 Perf 3214-28 1000 A 346,000 CFG
 SP 3191 28/3166-73 2000 A
 1,107,000 CFG 56 GWPH SP 3140
 36/3089-98 80/3101-21 5000 A
 4,555,000 CFG 25 GWPH SP 3084
 40/3042-52 16/3074-78 2000 A
 783,000 CFG 8 GWPH CO to 3472
 6,445,000 CFG PB 2936 12/2921-24
 16/2898-2902 1500 A 4,084,000 CFG
 7 GWPH CO to 3472 5,773,000 CFG.

1955

1/19

(Information continued)

15 GWPH PB 2842 28/2823-30


28/2782-89 2500 A 170,000 CFG

6 GWPH CO 6,117,000 CFG

Comp. 18,500,000 CFGPD 410#

COMPLETED

County Morton State Kansas
 Sec. 34 (Blk. 32 (Sur. 42W Map No.)
 (Twp.) (Rge.)
 Operator Colorado Oil & Gas
 Well No. 1 Farm Neuerburg
 Elev. 3490 Location C E $\frac{1}{2}$ E $\frac{1}{2}$ SW

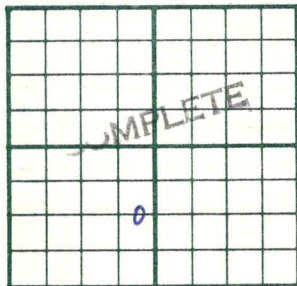

1320 Ft. From S Line SW
2600 Ft. From W Line Quarter

1st. Report

Completion JAN 1 9 1955

Remarks Greenwood Pool
Rocket Drlg. - Contr.

Spudding Date 11-8-54

Drlg. Data Gas well TD 3506

8 5/8" @ 651 Waubaunsee 2714

Elmont 2952 Top. 3093 LeCompton 3215

Lans. 3438 DST 2720-73 open 1 hr.

1,660,000 cfg 90' gcm 435#

DST 2788-2859 open 2 hr. DST 2872-2955

open 2 hr. Rec. 65' mud 35#

DST 3384-3421 open 2 hr. Rec. 20' mud

510# DST 3452-70 open 2 hr. Rec.

10' mud 0# TD 3506 5" @ 3501

CO to 3472 48/ 3446-58 2000 A

S/ wtr. 16/ 3260-64 S/ wtr. perf. 3247-

53 1000 A wtr. perf/ 3214-28 1000 A

346,000 cfg SP 3191 28/ 3166-73

2000 A 1,107,000 cfg 56 gwph SP 3140

FABEN GILSTRAP

Drlg. Data

36/ 3089-98	80/ 3101-21	5000 A
4,55 5,000 cfg	25 gwph	SP/ 3084
40/ 3042-52	16/ 3074-78	2000 A
783,000 cfg	8 gwph	CO to 3472
6,445,000 cfg	PB 2936	12/ 2921-24
16/ 2898-2902	1500 A	4,084,000 cfg
7 gwph	CO to 3472	5,773,000 cfg
15 gwph	PB 2842	28/ 2823-30
28/ 2782-89	2500 A	170,000 cfg
6 gwph	CO	6,117,000 cfg
Comp. 18,500,000 cfgpd		410#


Map No. _____ Sec. 34 Twp. 32 R. 42WWell No. 1 NeuerburgColorado Oil & Gas CompanyCORRECTION ContractorC $E\frac{1}{2}$ $E\frac{1}{2}$ SW

SECTION PLAT

_____ Ft. from N. Line

1320 Ft. from S. Line

_____ Ft. from E. Line

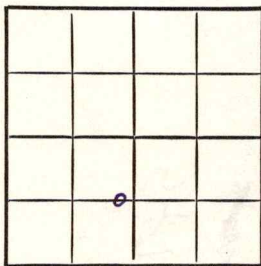2600 Ft. from W. LineMorton County

Location _____

Rig up _____

Drilling and Remarks:

Reported

#1 Neuerberger

C SW/4

RECORD

Cased _____ in., _____ ft.

Sand _____

Gas _____

Oil _____

Total Depth _____

PRODUCTION

1st 24 hrs. Nat. _____

1st 24 hrs. after shot _____

Gas _____ Cu. Ft.

Dry Hole _____

Abandoned _____

Date

NOV 23 1954

19

FABEN GILSTRAP

Scout

NOV 26 1954








County **Morton** State **Kansas**

Sec. 34 (Blk. Twp.) 32 (Sur. Rge.) 4 2W Map No.

Operator Colorado Oil & Gas

Well No. **1** Farm **Neuerberger**

Elev.	Location	C SW/4
-------	----------	--------

FIRST REPORT

1320 Ft. From S Line SW

1320 Ft. From **W** Line Quarter

1st. Report NOV 10 1954

Completion

Remarks

Rocket Drlg. - Contr.

Spudding Date _____

Drig. Data Greenwood Pool

R U R

FABEN GILSTRAP