


Section 14 Township 32 Range 42W

Well No. 1 Jackson

Company Colorado O & G

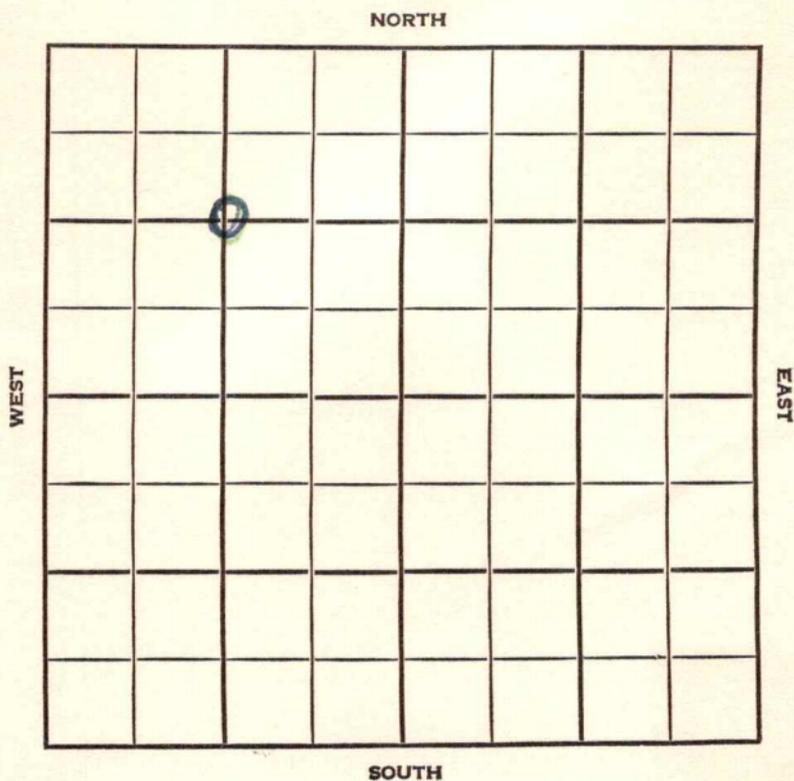

Morton

KANSAS


SEC.	TWP.	R.
14	32	42W

WELL NO. **1 Jackson** FARM

COMPANY **Colorado O & G**

CONTRACTOR **Holm Greenwood**

_____ Ft. from N. Line
 _____ Ft. from S. Line
 _____ Ft. from E. Line
 _____ Ft. from W. Line

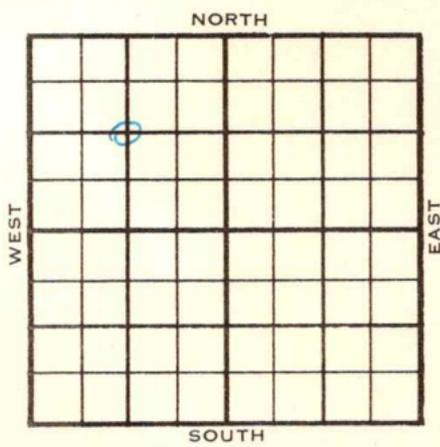

C NW/4

	ELEVATION	REPORT
1955	3492 DF	
6/29	Comm 6-25-55	8" @ 626/400 WOC
8/3	DST 2804-50 op 45" gas to surf 3" ga 2,770,000 cfg rec 250' gcm, FP 360- 360# BHP 880#; DST 3215-25 open 75" red. 15' gcm, FP 0#; BHP 10# 30" 5 1/2" 3289 1/2 w/150' CO 3228; 56/3136-38; 16/3127-31; 28/3100-07; 5000 A; 190, 000 cfg plus 45 gw; plug 3085; 32/3041 -49; 28/3025-32; 20/2014-19; 16/2989- 93; 8/2982-84; 8/2960-62; 5000A; ga 1,252,000 cfg plus 180 gwph; dr plug bott plug 2940; 8/2916-18 24/2906-12; 16/2893-97, 16/2872-76; 3500 A; top cem. 2862; perf 2830-41, perf 2822/ 28; 16/2814-18; 16/2808-12; 5000 A; test 6,489,000 cfg plus 14 gwph; 72- 20 13,000,000cfg SIP 435# Tp. Wab. 2795 H. Elm. 3041 Tr. Tp. 3199 Le Comp 3332	

COMPLETED

County Morton Elev. _____
 Sec. 14 Twp. 32 Rge. 42W
 Company Colorado O & G
 Farm Name Jackson No. 1

TOPS	DEPTH	LOG	DATUM
Anh.			
Tp.			
H.			
Tr.			
Dg.			
BL.			
L.			
K.C.			
B.K.C.			
Ce.			
C.			
M.			
M.			
K.			
Mz.			
Me.			
V.			
S.			
S.			
A.			
R.			
Pe.			
G.			
T.D.			

Loc. in Sec. C NW/4
 Geol. _____
 Contr. Holm
 Pool Greenwood

JUN 29 1955
FIRST REPORT

Date Comm. 6-25-55
3" @ 626/400 WOC

3A

Co.
 Lse.
 No.
 Sec.
 T.
 R.

County Morton Elev. 3492 DF
 Sec. 14 Twp. 32S Rge. 42W
 Company Colorado Oil & Gas
 Farm Name Jackson No. 1

TOPS	DEPTH	LOG	DATUM
Anh.			
Tp. <u>W 2 1/2 in.</u>		<u>2795</u>	
H. <u>Elm</u>		<u>3041</u>	
Tr. <u>TP</u>		<u>3199</u>	
Dg.			
Bl. <u>Le Comp</u>		<u>3332</u>	
L.			
K.C.			
B.K.C.			
Ce.			
C.			
M.			
M.			
K.			
Mz.			
Mq.			
V.			
S.			
S.			
A			
R.			
PE.			
G.			
T.D.	<u>3380</u>		

Loc. in Sec. C NW/4
 Geol. _____
 Contr. _____
 Pool Greenwood



Date Comm. 6-25-55; 8" 626 w/400; DST 2804-50
op 45", gas to surf 3", ga. 2,770,000 cfg
rec. 250' gcm, FP 360-360# BHP 880#;
DST 3215-25 open 75" rec. 15' gcm, FP 0#
BHP 10# 30"; 5 1/2" 3289 1/2 w/150; CO 3228;
56/3136-38; 16/3127-31; 28/3100-07; 5000 A;
190,000 cfg plus 45 gw; plug 3085;
32/3041-49; 28/3025-32; 20/3014-19;
16/2989-93; 8/2982-84; 8/2960-62; 5000 A;
ga 1,252,000 cfg plus 180 gwph; dr plug bott

Co.
 Lse.
 No.
 Sec.
 T.
 R.

plug 2940; 8/2916-18; 24/2906-12; 16/2893-97
16/2872-76; 3500 A; top cem. 2862; perf/2830-47
perf/2822-28; 16/2814-18; 16/2808-12; 5000 A;
test 6,489,000 cfg plus 14 gwph; 72-20
13,000,000 cfg SIP 435#

Scout Cards
Land Small Map
Land Wall Map
Tracings
Field Map
Plate Map
Misc

RC

AUG 10 1966