


DX 78-1

Morton KANSAS

Section 17 Township 32 Range 42W

Well No. 1 Stoops

Company Colorado O&G

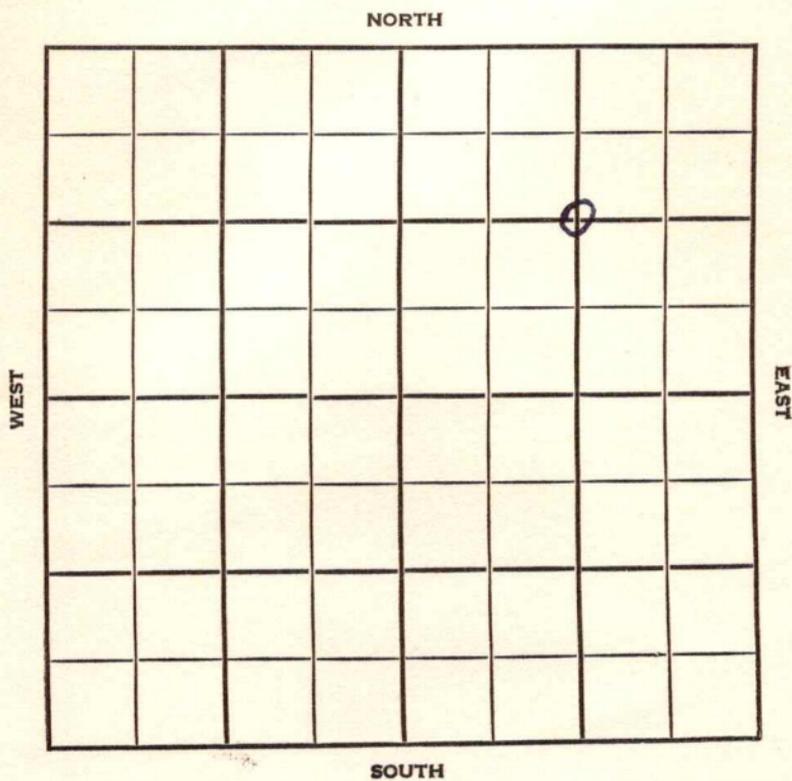

Morton KANSAS

SEC.	TWP.	R.
17	32	42W

WELL NO. 1 Stoops FARM
 COMPANY

Colorado O&G

CONTRACTOR Holm D. Jlg.


Greenwood Pool

1320 Ft. from N. Line

Ft. from S. Line

1320 Ft. from E. Line

Ft. from W. Line

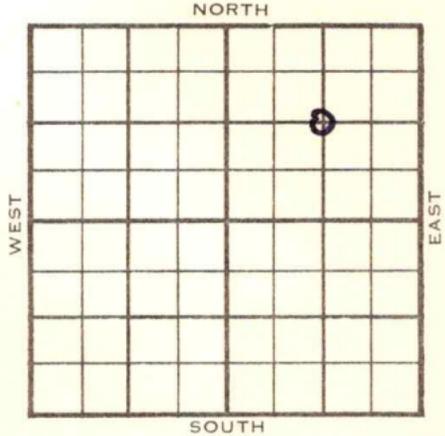

C NE/4

	ELEVATION	REPORT
1955		
4/20		Spud 4-17-55 Rng. surface pipe
5/25		Spud 4-17-55 8" @ 617 w/400 DST 3272-90 open 2 hr gas in 15 min rec 150' GCM, 180' muddy SW, 120' SW. 505/30" 5 1/2" @ 3236 CO to 3205 56/3166-80 24/3155-61 32/3141-49 500 A SP 3120 16/3096-3100 12/3083-86 16/3070- 74. 16/3043-47 2500 A 6,996 MCFG 5,419 MCFG 12 GWPH SP 3030' 24/2982-88 20/2947-52 12/2908-05 2500 A 386 MCFG 120 GWPH SP 2870 42/2846-53 12/2829-31 48/2806-14 24/2798-2802 4000 A 6,020 MCFG 6,098,000 CFG 15 GWPH SP 2790 108/2761-51 4000 A 8,570 MCFG SP 3200 9,690,000 MCFG Comp. 19,611 MCFGPD 435#
		COMPLETED


County Morton State Kansas

Sec. 17 (Blk. Twp.) 32 (Sur. Rge.) 42W Map No.

Operator Colorado Oil & Gas

Well No. 1 Farm Stoops

Elev. _____ Location C NE/4

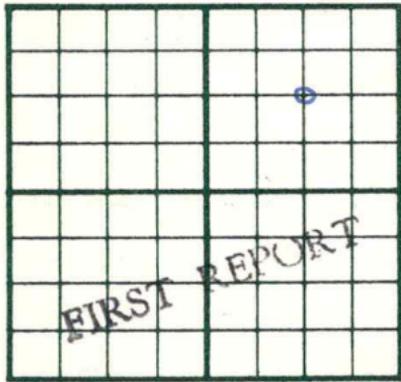

1320 Ft. From N Line NE

1320 Ft. From E Line Quarter

1st. Report APR 20 1955

Completion _____

Remarks _____

Holm Drlg. - Contr.

Spudding Date 4-17-55

Drlg. Data Greenwood Pool

rng. surface pipe


FABEN GILSTRAP

COMPLETED

County Morton Elev. _____
 Sec. 17 Twp. 32 Rge. 42W
 Company Colorado Oil & Gas
 Farm Name Stoops No. 1

TOPS	DEPTH	DATUM
Cim. Anhydrite		
Ft. Riley <u>Lacomp</u>	<u>3271</u>	
Howard <u>Waub</u>	<u>2785</u>	
Topeka <u>Elm.</u>	<u>3141</u>	
Heebner Sh.		
Toronto Ls.		
Brown Lime		
Lansing		
Kans. City		
B. K. C.		
Congl.		
Miss.		
Kinderhook		
Misener		
Hunton		
Sylv. Maquo		
Viola		
Simpson		
Smp.		
Gorham		
Arbuckle		
Basal Sand		
Pre. Cam.		
T. D.		

Loc. in Section C NE/4
 Drlg. Contr. Holm Drlg.
 Pool Greenwood

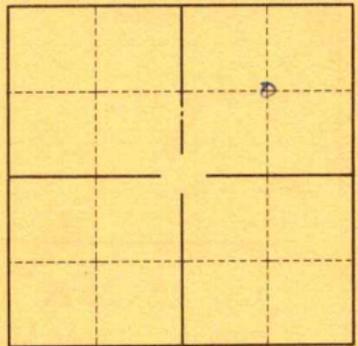

Date Comm. _____
 Date Comp. MAY 25 '55

Spud 4-17-55 8" @ 617 w/ 400
 DST 3272-90 open 2 hr. gas in 15 min.
 Rec. 150' gcm 180' muddy sw 120' sw
 505/30" 5 1/2" @ 3236 CO to 3205
 56/ 3166-80 24/ 3155-61 32/ 3141-49
 500 A SP 3120 16/ 3096-3100
 12/ 3083-86 16/ 3070-74 16/ 3043-47
 2500 A 6,996 mcfg 5,419 mcfg 12 gwph
 SP 3030 24/ 2982-88 20/ 2947-52
 12/ 2908-05 2500 A 386 mcfg 120 gwph

Co.
 Lse.
 No.
 S.
 T.
 R.

SP 2870 42/ 2846-53 12/ 2829-31
38/ 2806-14 24/ 2798-2802 4000 A
6,020 mcfg 6,098,0000 cfig 15 gwph
SP 2790 108/ 2761-51 4000 A
8,570 mcfg SP 3200 9,690,000 mcfg
Comp. 19,611 mcfgpd 435#

JUN 10 1955

Land Cards
Land Small Map
Land Wall Map
Tracings
France Map
Pierce Map
Misc.

mm

CONFIDENTIAL