

Morton


KANSAS

SECTION 26 TOWNSHIP 32 RANGE 42 W

WELL NO. #1 Withroder

COMPANY Champlin Ref.

NORTH

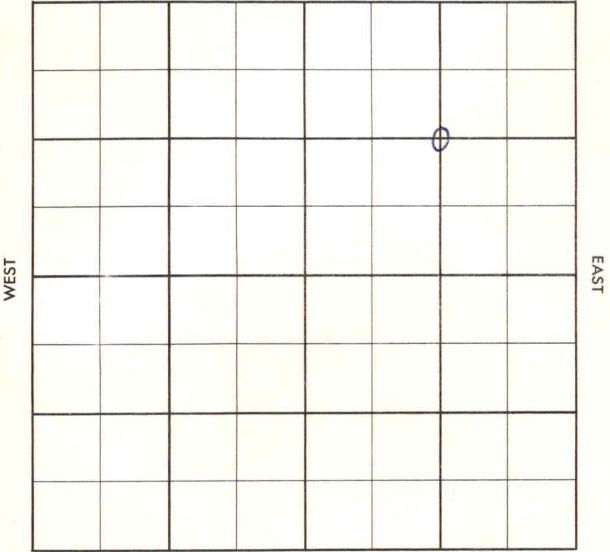

SOUTH

Morton

KANSAS

SEC. 26	TWP. 32	R. 42W
------------	------------	-----------

WELL NO.

#1 Withroder

FARM

COMPANY

Champlin Ref.

CONTRACTOR

Garvey

Greenwood


_____ Ft. from N. Line

_____ Ft. from S. Line

_____ Ft. from E. Line

_____ Ft. from W. Line

C NE/4

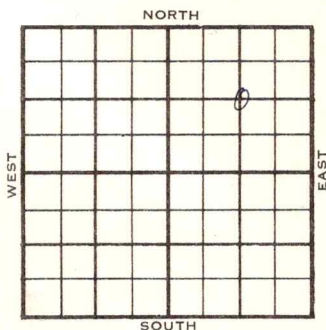

1956

ELEVATION

3489

REPORT

1-25

MIR

3-21

Comm. 1-25-56

10" @ 651/425

DST 2999-3082 op 2 hrs., rec. 125' mud,
255/30"DST 3201-53 op 70 min, gas to surface
in 8 min, 1250 mcfg, rec. 290' mud,
435/20"

7" @ 3359/650

CO to 3318, 16/ 3206-14, 24/ 3219-25,
64/ 3226-42, 16/ 3280-84, 20/ 3290-95876 mcfg, 1000 A, 3560 mcfg, 50 gwph,
400 A, 6530 mcfg, 15 gwph,SP 3200, 40/ 3132-42, 20/ 3107-12,
20/ 3061-66, 5000 A, 5116 mcfg,

85 gswph,

SP 3049, 20/ 3037-42, 8/ 3032-34,

12/3014-17, 16/ 3002-08, 20/ 2841-46

16/ 2824-28, 9000 A, 5116 mcfg,

85 gwph,

CO to 3314, 15,000 A,

6472 mcfg, 95 gwph,

Comp. 16,969 mcfgpd, 410#

Log tops:

Wab. 2812

Elm 3060

Tp 3206

TD 3360'

COMPLETED

County Morton Elev. _____
 Sec. 26 Twp. 32 Rge. 42W
 Company Champlin Ref.
 Farm Name Withroder No. 1

TOPS	DEPTH	LOG	DATUM	Loc. in Sec.
Anh.				C NE/4
Tr.				
Dg.				
B.L.				
L.				Geol. _____
K.C.				Contr. _____
B.K.C.				Garvey
Ce.				
C.				Pool Greenwood
M.				
M.				
K.				
Mz.				
Me.				
V.				
S.				
S.				
A.				
R.				
PC.				
G.				
T.D.				

Date Comm. M I R

~~34~~

Co.
Lse.
No.
Sec.
T.
R.

County Morton Elev. 3489
 Sec. 26 Twp. 32 Rge. 42W
 Company Champlin Ref.
 Farm Name Withroder No. 1

TOPS	DEPTH	LOG	DATUM	Loc. in Sec.
Anh. <u>Wab</u>		<u>2812</u>		<u>C NE/4</u>
Tp. <u>E/m</u>		<u>3060</u>		
H. <u>TP</u>		<u>3206</u>		
Tr.				
Dg.				
Bl.				
L.		<u>3338</u>		Geol. _____
K.C.				Contr. _____
B.K.C.				<u>Garvey</u>
Ce.				
C.				Pool _____
M.				<u>Greenwood</u>
M.				
K.				
Mz.				
Me.				
V.				
S.				
S.				
A.				
R.				
Pe.				
G.				
T.D.	<u>3360</u>			COMPLETE

Date Comm. 1-25-56 MAR 21 1956

10" @ 651/425 DST 2999-3082 open 2 hr.

rec. 125' mud 255/30" DST 3201-53

open 70 min. gas to surface in 8 min.

1,250 mcfg rec. 290' mud 435/20"

7" @ 3359/650 CO to 3318 16. 3206-14

24/ 3219-25 64/ 3226-42 16/ 3280-84

20/ 3290-95 876 mcfg 1000 A

3,560 mcfg 50 gwph - 400 A

OVER

6,530 mcfg 15 gwph SP 3200

40/ 3132-42 20/ 3107-12 20/ 3061-66

5000 A 5,116 mcfg 85 gswph SP 3049

20/ 3037-42 8/ 3032-34 12/ 3014-17

16/ 3002-08 20/ 2841-46 16/ 2824-28

9000 A 5,116 mcfg 85 gwph CO to 3314

15000 A 6,472 mcfg 95 gwph

Comp. 16,969 mcfgpd 410#

APR 2 1956
R. G.