


Section 27 Township 32 Range 42W

Well No. #1 Pankratz

Company Colorado O & G

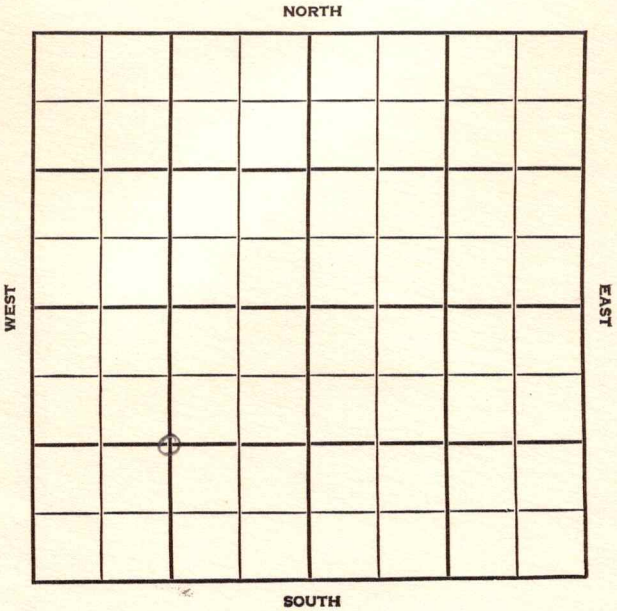


Morton		KANSAS
SEC.	TWP.	R.
27	32	42 W
WELL NO.		
# 1 Pankratz		FARM
COMPANY		
Colorado O & G		
CONTRACTOR		
Garvey		
Greenwood		

_____ Ft. from N. Line

_____ Ft. from S. Line

_____ Ft. from E. Line

_____ Ft. from W. Line

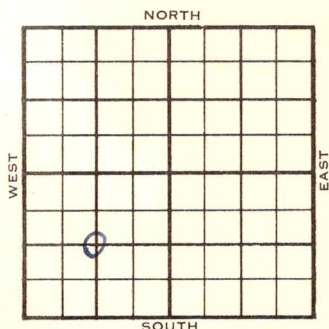

C SW/4

	ELEVATION	REPORT
1955		
6/8	Comm. 6-1-55 8" @ 614/450 Drlg. 2943'	
7/20	DS_t 3260-74, open $\frac{1}{2}$ hr. REc 340 mcfg $\frac{1}{2}$ hr. Rec 60' gcm 500/30" 5$\frac{1}{2}$" @ 3329 CO to 3300 per 3253/66 2000 A 1,419 mcfg 20 gwph S^r 3230 perf 3208-12, 3196-3201 2000A 1,799 mcfg 22 gwph, CO to 3300 2,797 mcfg 12 gwph SP 3180 prf /3141-57 3123-30 4000 A 5,510 mcfg CO to 3300 5,419 mcfg 12 gwph SP 3105, 28/3078-85 20/3050-55, CO to 3300 4,3 -93 mcfg SP 3000 perf 2982-84 2949-57 2926-29 3000 A, 4,640 mcfg 23 gwph SP 2880 perf 2852-56, 2812-16, 2000A CO 12/2775-78 16/2768-72 8/2760-62, 20/2750-55, 2500 A 2,950 mcfg 28 gwph CO to 3300 9,690 mcfg Comp. 21,250 mcfgpd.	
	Tops	Depth
	Ahn.	2736
	TP Elmont	2981
	H. tp	3122
	Tr. Le Comp	3248
	TD	3334

COMPLETED

County Morton Elev. _____

Sec. 27 Twp. 32 Rge. 42W

Company Colorado O & G

Farm Name Pankratz No. 1

TOPS	DEPTH	LOG	DATUM	Loc. in Sec.
Anh.				<u>C SW/4</u>
Tp.				
H.				
Tr.				
Dg.				
Bl.				
L.				Geol. _____
K.C.				Contr. _____
B.K.C.				<u>Garvey</u>
Ce.				Pool _____
C.				<u>Greenwood</u>
M.				
M.				
K.				
Mz.				
Me.				
V.				
S.				
S.				
A.				
R.				
Pe.				
G.				
T.D.				

EWST REPORT

JUN 8 1955

Date Comm. 6-1-55

8" @ 614/450 drlg. 2943

K-34

County Morton Elev. _____
 Sec. 27 Twp. 32 Rge. 42W
 Company Colorado O & G
 Farm Name Pankratz No. 1

TOPS	DEPTH	LOG	DATUM	Loc. in Sec.
Anh. <u>Waub</u>		<u>2736</u>		<u>C SW/4</u>
Tp. <u>Elment</u>		<u>2981</u>		
H. <u>T.P.</u>		<u>3122</u>		
Tr. <u>LaComp</u>		<u>3248</u>		
Dg.				
BL.				
L.				Geol. _____
K.C.				Contr. _____
B.K.C.				
Ce.				<u>Garvey</u>
C.				
M.				Pool _____
M.				<u>Greenwood</u>
K.				
Mz.				
Mq.				
V.				
S.				
S.				
A.				
R.				
Pe.				
G.				
T.D.	<u>3334</u>			

COMPLETE

Date Comm. 6-1-55 JUL 20 1955
 8" @ 614/450 DST 3260-74 open $\frac{1}{2}$ hr.
 Rec. 340 mcf $\frac{1}{2}$ hr. Rec. 60' gcm
 500/30" 5 $\frac{1}{2}$ " @ 3329 CO to 3300
 per/ 3253-66 2000 A 1,419 mcf g
 20 gwph SP 3230 perf. 3208-12
 3196-3201 2000 A 1,799 mcf g 22 gwph
 CO to 3300 2,797 mcf g 12 gwph
 SP 3180 perf/ 3141-57 3123-30

OVER

4000 A 5,510 mcfg CO to 3300 5,419 mcfg
12 gwph SP 3105 28/ 3078-85 20/ 3050-55
16/ 3028-32 3000 A 1,564 mcfg
CO to 3300 4,393 mcfg SP 3000
perf. 2982-84 2949-57 2926-29 3000 A
4,640 mcfg 23 gwph SP 2880
perf. 2852-56 2812-16 2000 A
CO 12/ 2775-78 16/ 2768-72 8/ 2760-62
20/ 2750-55 2500 A 2,950 mcfg 28 gwph
CO to 3300 9,690 mcfg
Comp. 21,250 mcfgpd

Scout Cards
Large Small Map
Land Wall Map
Tracings
France M-P
Place Map
Misc.

JUL 27 1955