
Morton KANSAS

SECTION 33 TOWNSHIP 32 RANGE 42 W

WELL NO. #1 Knoeber "A"

COMPANY Cities Service

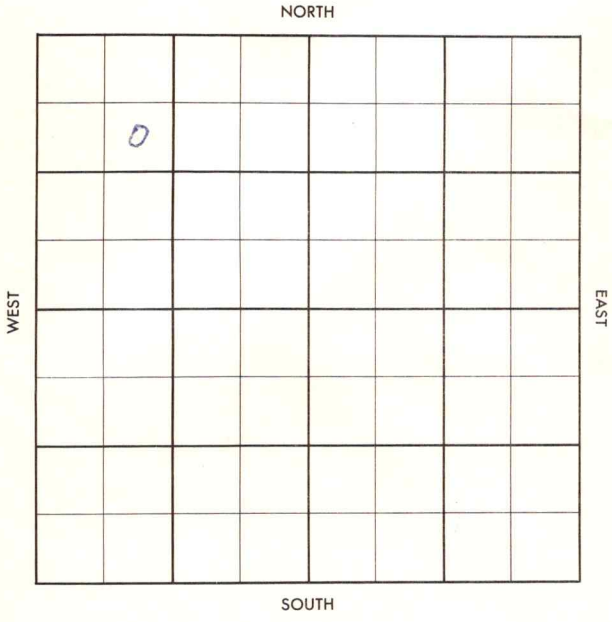

FORM 504-3 SUNRAY

Morton KANSAS

SEC.	TWP.	R.
33	32	42W

WELL NO.
#1 Knoeber "A" FARM

COMPANY
Cities Service

CONTRACTOR
Holm Drlg.

Greenwood


1250 Ft. from N. Line

_____ Ft. from S. Line

_____ Ft. from E. Line

1250 Ft. from W. Line

SE NW NW

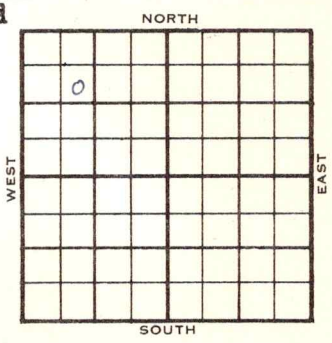

1955	ELEVATION 3506' REPORT
11-30	Location
12-28	Comm. 11-26-55 8 5/8" @ 600 5½" @ 3208 CO to 3172 152/3070-3108,4000 A, 4,820 mcfg, SP 3055, 28/ 3023-30, 72/ 2996-3017 44/ 2973-84, 40/ 2932-42, 5000 A 4,950 mcfg, 2000 A, CO to 3172 Comp. open flow/ 14,400 mcfgpd, 413# Tp. 2927' TD 3209' COMPLETED

DX-78

FORM 513 REV. SUNRAY

County Morton Elev. 3506

Sec. 33 Twp. 32 Rge. 42W

Company Cities Service

Farm Name Knoeber "A" No. 1

TOPS	DEPTH	LOG	DATUM
Anh.			
Tp.	2927		
H.			
Tr.			
Dg.			
B.L.			
L.			
K.C.			
B.K.C.			
Ce.			
C.			
M.			
M.			
K.			
Mz.			
Mg.			
V.			
S.			
S.			
A			
R.			
P€.			
G.			
T.D.	3209		

Loc. in Sec. SE NW NW

1250' NL

1250' WL

Geol.

Contr. Holm Drlg.

Pool Greenwood



Date Comm. 11-26-55 DEC 28 1955

8 5/8" @ 600 5½" @ 3208 CO to 3172

152/ 3070-3108 4000 A 4,520 mcfg

SP 3055 28/ 3023-30 72/ 2996-3017

44/ 2973-84 40/ 2932-42 5000 A

4,950 mcfg 2000 A CO to 3172

Comp. open flow/ 14,400 mcfgpd 413#

Co. Lse. No. Sec. T. R.

FORM 513 REV. SUNRAY

County Morton Elev.

Sec. 33 Twp. 32 Rge. 42W

Company Cities Service

Farm Name Knoeber "A" No. 1

TOPS	DEPTH	LOG	DATUM
Anh.			
Tp.			
H.			
Tr.			
Dg.			
B.L.			
L.			
K.C.			
B.K.C.			
Ce.			
C.			
M.			
M.			
K.			
Mz.			
Mo.			
V.			
S.			
S.			
A			
R.			
P€.			
G.			
T.D.			

Loc. in Sec. SE NW NW

1250' NL

1250' WL

Geol.

Contr. Holm Drlg.

Pool Greenwood

NOV 30 '55

FIRST REPORT

Date Comm.

Location

Co. Lse. No. Sec. T. R.

34