


Section 13 Township 32 Range 42 W

Well No. #1 Withroder

Company Colorado O & G

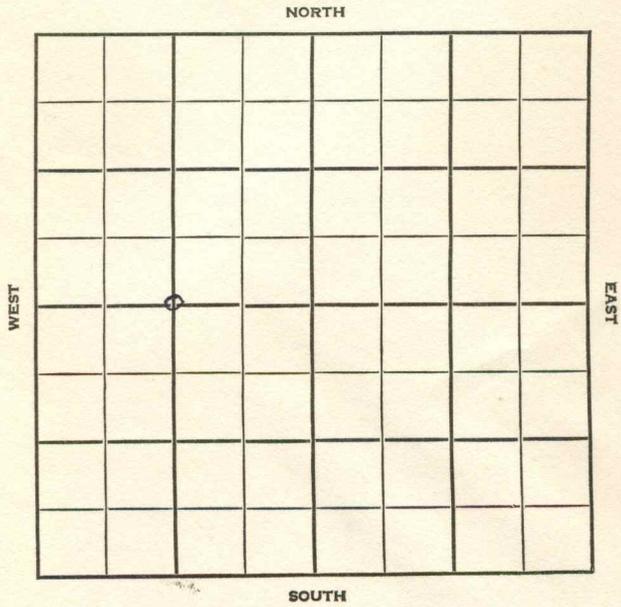

SEC. <u>13</u>	TWP. <u>32</u>	R. <u>42W</u>
----------------	----------------	---------------

WELL NO. #1 Withroder FARM

COMPANY Colorado O&G

CONTRACTOR Greenwood


\_\_\_\_\_ Ft. from N. Line

\_\_\_\_\_ Ft. from S. Line

\_\_\_\_\_ Ft. from E. Line

\_\_\_\_\_ Ft. from W. Line

C  $W\frac{1}{2}$  Sec.

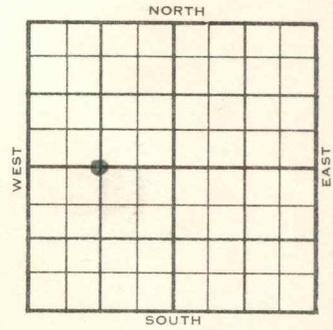

1955	ELEVATION <u>3480</u>	REPORT
------	-----------------------	--------

8/3 Location **FIRST REPORT**

10/12 Abd Loc.

**ABANDONED**

