FORM 51


Morton

KANSAS

Section 5 Township 32 Range 43W

Well No. #1 Dryer "B"

Company Colorado Oil & Gas & Superior Oil

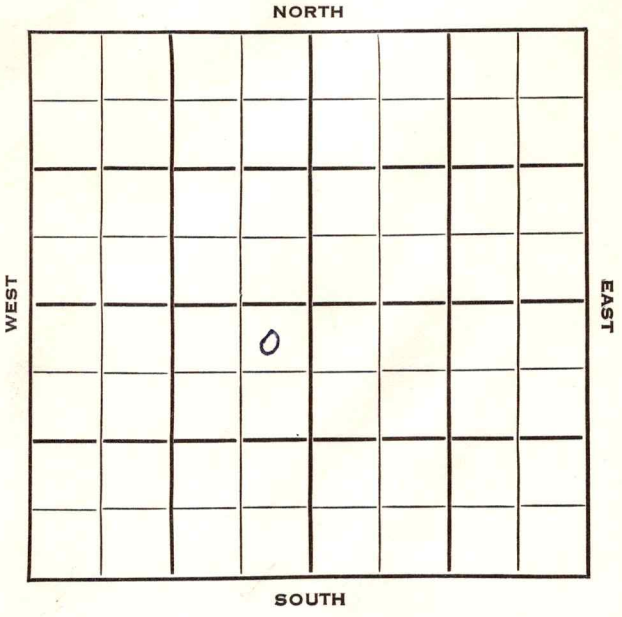

Merton

KANSAS

SEC.	TWP.	R.
5	32	43W

WELL NO. #1 Dyer "B" FARM

COMPANY

Colorado Oil & Gas & Superior Oil

CONTRACTOR

Russell & Hatfield

Wildcat.


330 Ft. from N. Line

Ft. from S. Line

330 Ft. from E. Line

Ft. from W. Line

NE NE SW

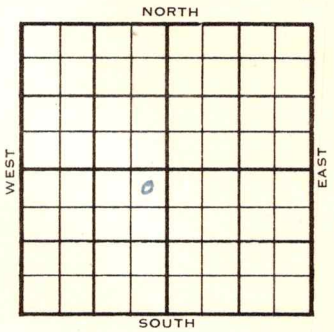

	ELEVATION	REPORT
1953	3631'	
		KC Test
10/7	Spud 10-1-53 8" @ 596' Drlg 2485'	
10/14	RTD 3555 Schl 5" @ 3476' Lans 3270'	
10/21	85/ 3302-16 S/ 5 bswph PB 3296	
1954 1/13	Spud 10-1-53 Gas Well TD 3555' 8" @ 596' Lans 3270' TD 3555' 5" @ 3476' 83/3302-16, S/5 bswph PB 3296 72/3274-86, 1500A, S/7 bswph SSG, SP 3268, 20/3239-44, 20/3219-24, 56/3152-66, 32/3138-46, 2000A 1,096,000 gas, 15000A 2,800,000 gas, 3000A, 9000A, SP 3124 24/3096-3100, 20/3080-84, 60/3054-64, 48/3034-42, 30/2979-84, 18/2966-69 105000A, 4,430,000 gas	

DX-78

OVER

(Information Brought Forward)

1954
1/13 CO to 3268
4000A
6 2/3 mcfg
Wab. 2855', Elmont 2962', Top 3136',
Lans 3270'
Comp. 4 3/4 mcfgpd

COMPLETED

3631
3136
+495

FORM 275 FOR SALE BY KANSAS BLUE PRINT CO.

County Morton State Kansas

Sec. 5 (Blk. Twp.) 32 (Sur. Rge.) 43W Map No.

Operator Colorado Oil & Gas & Superior Oil

Well No. 1 Farm Dryer "B"

Elev. Location NE NE SW



330 Ft. From N Line SW

330 Ft. From E Line Quarter

1st. Report OCT 7 1953

Completion

Remarks KC test

Russell & Hatfield - Contr

Spudding Date 10-1-53

Drlg. Data Wildcat

8" @ 596 drlg. 2485

J. G. McGEHEE

FORM 275 FOR SALE BY KANSAS BLUE PRINT CO.

County Morton State Kansas

Sec. 5 (Blk. Twp.) 32 (Sur. Rge.) 43W Map No.

Operator Colorado Oil & Gas & Superior Oil

Well No. 1 Farm Dryer "B"

Elev. 3631 Location NE NE SW



330 Ft. From N Line SW

330 Ft. From E Line Quarter

1st. Report

Completion JAN 13 1954

Remarks Wildcat

Russell & Hatfield - Contr

Spudding Date 10-1-53

Drlg. Data Gas well TD 3555

8" @ 596 Lans. 3270 TD 3555 5" @ 3476

85/ 3302-16 S/ 5 bswph PB 3296

72/ 3274-86 1500 A S/ 7 bswph SSG

SP 3268 20/ 3239-44 20/ 3219-24

56/ 3152-66 32/ 3138-46 2000 A

1,096,000 gas 15000 A 2,800,000 gas

3000 A 9000 A SP 3124 24/ 3096-3100

20/ 3080-84 60/ 3054-64 48/ 3034-42

30/ 2979-84 18/ 2966-69 10500 A

4,430,000 gas CO to 3268 4000 A

6 2/3 mcfg Wab. 2855 Elmont 2962

Top. 3136 Lans. 3270

Comp. 4 3/4 mcfgpd

J. G. McGEHEE