
DX 78-1

Morton KANSAS

Section 14 Township 32 Range 43 W

Well No. # 1 Mansz

Company Colorado O & G

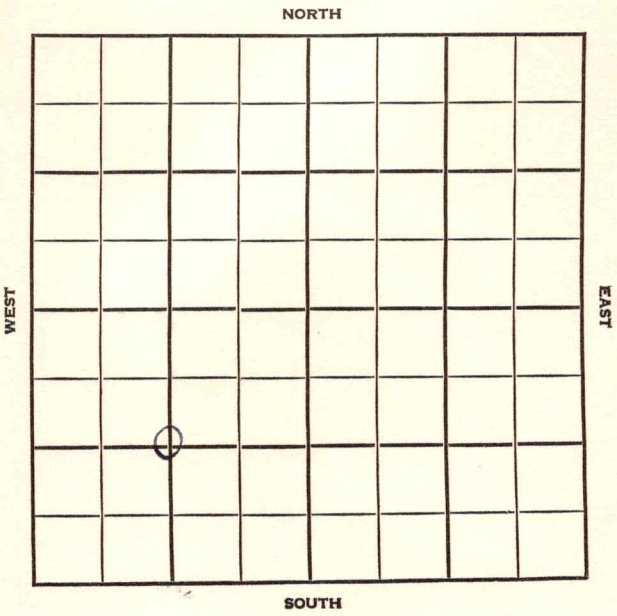

Morton KANSAS

| SEC. | TWP. | R. |
|---|---|---|
| 14 | 32 | 43W |

WELL NO.

#1 Mansz FARM

COMPANY

Colorado O & G

CONTRACTOR

Holm Drlg.

Greenwood Pool


_____ Ft. from N. Line

1320 Ft. from S. Line

_____ Ft. from E. Line

1320 Ft. from W. Line

C SW/4

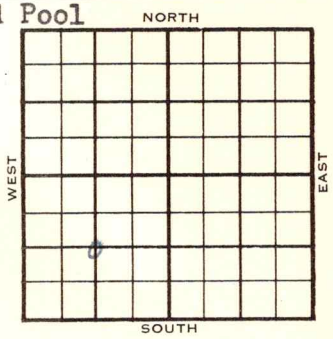


| | ELEVATION | REPORT |
|---|---|---|
| 1954 | 3591' | |
| 10/27 | M I R | |
| 1955 2/23 | Spud 10-25-54 Gas well TD 3370 8" @ 665 TD 3370 5" @ 3370 72/3237-55 2,159,000 CFG 3500 A 6,859,000 CFG Wab. 2699 Elmont 2928 Top 3079 LeCompton 3221 20/3195-3200 16/3184-88 2000 A 4,402,000 CFG PB 3143 84/3105-26 60/3085-3100 7000 A 15,800,000 CFG PB 3070 20/3045-50 16/3033-37 36/3017-26 4000 A 8,600,000 CFG 40 GWPH DP 3307 26,010,000 CFG SP 3010 24/2995-3001 1500 A 15,600,000 CFG SP 2960 16/2941-46 1000 A 7 to 10 GWPH SP 2928 28/2907-14 12/2895-98 1500 A 769,000 CFG 8 GWPH DP 19,611,000 CFG SP 2850 20/2815-20 20/2807-11 12/2792-95 200 A SP 2790 16/2739-43 32/2725-33 16/2705-09 3000 A 455,000 CFG CO 3340' 19,611,000 CFG Comp. 27,800,000 CFGPD 425# COMPLETED | |

DX-78

FORM 275 FOR SALE BY KANSAS BLUE PRINT CO.

County Morton State Kansas

Sec. 14 (Blk. Twp.) 32 (Sur. Rge.) 43W Map No.

Operator Colorado Oil & Gas

Well No. 1 Farm Mansz

Elev. Location C SW/4




1320 Ft. From S Line SW Quarter

1320 Ft. From W Line

1st. Report OCT 27 1954

Completion

Remarks Holm Drlg. - Contr.

Spudding Date Greenwood Pool

Drlg. Data M I R

FABEN GILSTRAP

FORM 275 FOR SALE BY KANSAS BLUE PRINT CO

County Morton State Kansas

Sec. 14 (Blk. Twp.) 32 (Sur. Rge.) 43W Map No.

Operator Colorado Oil & Gas

Well No. 1 Farm Mansz

Elev. 3591 Location C SW/4




1320Ft. From S Line SW

1320Ft. From W Line Quarter

1st. Report

Completion FEB 23 1955

Remarks Greenwood Pool

Holm Drlg. - Contr.

Spudding Date 10-25-54

Drlg. Data Gas well TD 3370

8" @ 665 TD 3370 5" @ 3370

72/ 3237-55 2,159,000 cfg 3500 A

6,859,000 cfg Wab. 2699 Elmont 2928

Top. 3079 LeCompton 3221 20/ 3195-3200

16/ 3184-88 2000 A 4,402,000 cfg

PB 3143 84/ 3105-26 60/ 3085-3100

7000 A 15,800,000 cfg PB 3070

20/ 3045-50 16/ 3033-37 36/ 3017-26

4000 A 8,600,000 cfg 40 gwph

DP 3307 26,010,000 cfg SP 3010

24/ 2995-3001 1500 A 15,600,000 cfg

SP 2960 16/ 2941-46 1000 A 7 to 10

gwph SP 2928 28/ 2907-14 12/ 2895-98

1500 A 769,000 cfg 8 gwph DP

OVER

FABEN GILSTRAP

Drlg. Data

19,611,000 cfg SP 2850 20/ 2815-20
20/ 2807-11 12/ 2792-95 200 A
SP 2790 16/ 2739-43 32/ 2725-33
16/ 2705-09 3000 A 455,000 cfg CO
3340 19,611,000 cfg
Comp. 27,800,000 cfgpd 425#

