
Morton KANSAS

SECTION 17 TOWNSHIP 32S RANGE 43W

WELL NO. #1 Dreyer

COMPANY Huber

NORTH C SE SE

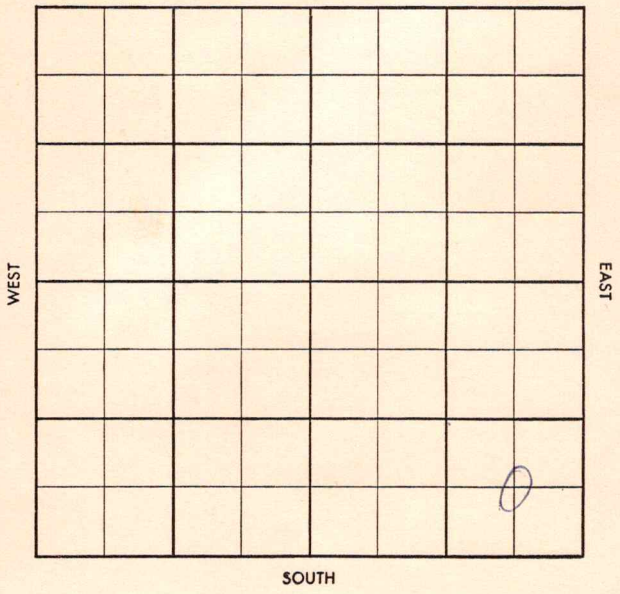

FORM 504-3 SUNRAY

3A

S—513-A

CO. Morton ELEV. 3634

SEC. 17 TWP. 32 RGE. 43W

COMPANY Huber NO. 1

FIRST REPORT
OCT 9 '57

FARM Dreyer

LOC. C SE SE

Colorado O & G

GEOL.

CONTR. Co. tools

POOL Wildcat

SPUD

M I R

CO.
LSE.
NO.
SEC.
TWP.
RGE.

20

S-513-A

CO. Morton ELEV. 3645KB 3634

SEC. 17 TWP. 32 RGE. 43W

COMPANY Huber NO. 1

COMPLETE DEC 11 '57

FARM Dreyer

LOC. C SE SE

Colorado O & G

GEOL.

CONTR. Co. tools

POOL ~~Wildcat~~ Reyer

SPUD 10-10-57

M I R OCT 16 '57

8" 1461/750

TD 2765

OCT 23 '57 Hb 3304

Lsg 3456 Mar 3915 DST 3976 - 4021 60" G/4" ga 377 mcf/15 506 mcf/30" 540 mcf/60" rec 200' GCM FP 120-165 BHP 895-850/30" Ce 4210 Atoka 4335 Morsh 4634 Pundy 4788-96 DST 4782 4900 60" 15'M FP 0-0 BHP 1515/30 TD 5048 OCT 30 '57 DST 4998-5045 60" 360'M NS FP 0 BHP 1055/30'

DST 5040-80 60" 60'S GCM 540' GCSW FP 55-270 BHP 1100/20" Chest 5083 St Sm 5114 TD 5175 Log Lsg 3465 Mar 3912 Atoka 4330 Morsh 4632 Pundy 4789-96 Mor Li 4932 "G" Sd 5008 keys 5046 Chester 5085 St Sm 5107 LTD 5165 5½" 4320 NOV 6 '57 CO NOV 13 '57 NOV 20 '57 8/4146-48 ½ BSW ph 6hrs 16/4132-36 ¾ BSW ph 3hrs BHP 4050 16/4014-16 ga 340 mcf + 6 g sw ph 11hrs 24/4008-14 ½ ga 624 MCF + 4 BSW ph 12hrs SI 8/3999-4001 24/3993-99 NS Wet ½ ga 264 mcf + 55 g sw ph 11 ga 1.300 mcf + 3½ BSW ph decr to 20 g sw ph 15hrs T&R NOV 27 '57 SICP & TP 700# 17hrs ga 2.025 mcf 2hrs thg Dry SICP 720 SITP 720 14hrs ga 1.881 mcf 4hrs + h Dry FCP 280 57 DEC 1 '57 ga 2.530 mcf dry 3hrs DEC 11 '57 ga 2.652 mcf SITP 743

CO. LSE. NO. SEC. TWP. RGE.

FORM 513-1 SUNRAY 2.650 mcf SID 743#

Marm 3993-4001

PBTD 4006