


Section 20 Township 32 Range 43W
Well No. 1 Hersberger
Company Colorado Oil & Gas

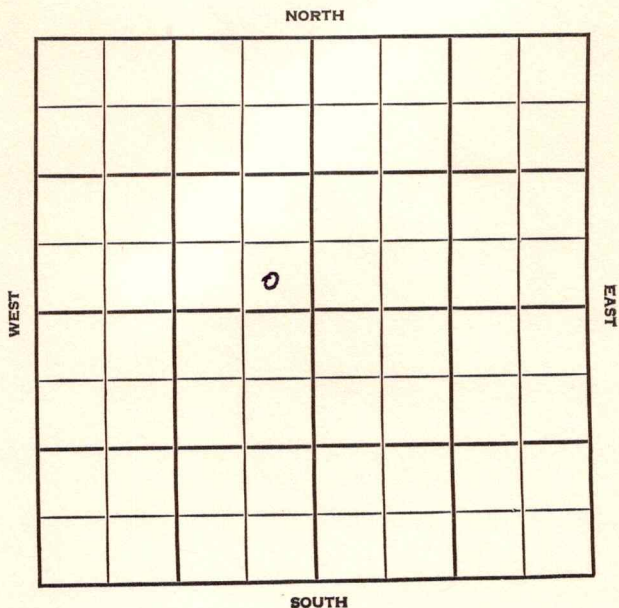

Morton

KANSAS

SEC.	TWP.	R.
20	32	43 W

WELL NO.

1 Hershberger

FARM

COMPANY

Colorado Oil & Gas

CONTRACTOR


Ft. from N. Line

330 Ft. from S. Line

330 Ft. from E. Line

Ft. from W. Line

SE SE NW

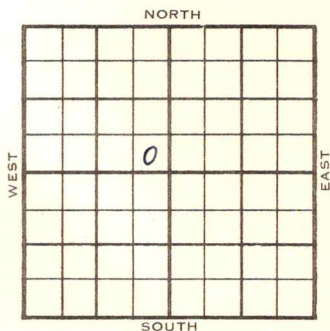

1954

ELEVATION

REPORT

5/26
6/2Pipe Set
NR

12/8

Spud 5-10-54 Gas well TD 3375
 8" @ 623 Elmont 2919 Top. 3080
 TD 3375 5" @ 3350 60/3042-52
 48/3022-30 48/3004-12 30/2975-80
 5000 A 1½ MCFG CO to 3295
 40/3210-20 100,000 CFG 2500 A
 780,000 CFG 15 GWPH PB 3120
 88/3076-98 900,000 CFG 5000 A
 8,800,000 CFG 15 GWPH SP 3050
 32/3030-38 32/3014-22 36/2994-
 3003 32/2974-82 4000 A
 810,000 CFG
 Comp. 10,200,000 CFGPD 435#

COMPLETED

County **Morton** State **Kansas**

Sec. **20** (Blk.) **32** (Sur.) **43W** Map No.

Operator **Colorado Oil & Gas**

Well No. **1** Farm **Hershberger**

Elev. Location **SE SE NW**

330 Ft. From **S** Line **NW**

330 Ft. From **E** Line Quarter

1st. Report **MAY 26 1954**

Completion


Remarks

Spudding Date

Drlg. Data

pipe set

County Morton State Kansas
 Sec. 20 (Blk.) 32 (Sur.) 43W Map No.
 Operator Colorado Oil & Gas
 Well No. 1 Farm Hershberger
 Elev. _____ Location SE SE NW

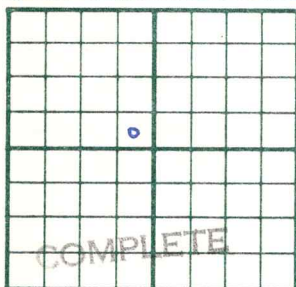

330 Ft. From S Line NW

330 Ft. From E Line Quarter

1st. Report

Completion DEC 8 1954

Remarks

Spudding Date 5-10-54

Drlg. Data Gas well TD 3375

8" @ 623 Elmont 2912 Top. 3080

TD 3375 5" @ 3350 60/ 3042-52

48/ 3022-30 48/ 3004-12 30/ 2975-80

5000 A 1½ mcfg CO to 3295 40/ 3210-20

100,000 cfg 2500 A 780,000 cfg

15 gwph PB 3120 88/ 3076-98

900,000 cfg 5000 A 8,800,000 cfg

15 gwph SP 3050 32/ 3030-38 32/ 3014-

22 36/ 2994-3003 32/ 2974-82 4000 A

810,000 cfg Comp. 10,200,000 cfcpd 435#

FABEN GILSTRAP