


Section 24 Township 32 Range 43W  
Well No. #1 J. B. Smith "B" Unit  
Company Texas Co.

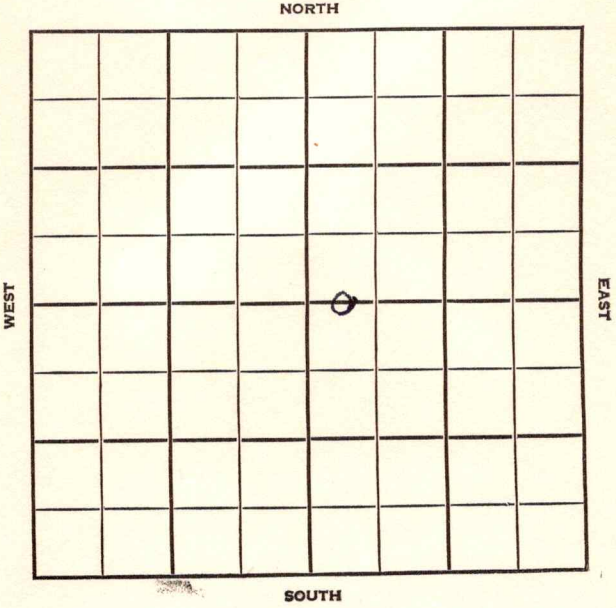

Morton KANSAS

SEC.	TWP.	R.
24	32	43W

WELL NO. 1 J. B. Smith "B" Unit FARM

COMPANY Texas Co.

CONTRACTOR Walter Kuhn  
Greenwood Pool


2640 Ft. from N. Line

Ft. from S. Line

2490 Ft. from E. Line

Ft. from W. Line

C W/2 W7/2 E/2 Sec.

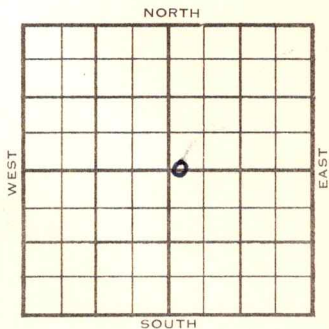

1955	ELEVATION	REPORT
	3574'	

4/6 Spud 4-3-55  
10" @ 723'  
Drlg. 729'

5/25 Lsg 3224; TD 3299; 10" 723;  
7" 3299; PB: CO 3278; 40/3238-48  
492,000 cfg no wtr; 1000A; 760,000  
cfg plus 1/2 bw; 2000A; perf 3913-99;  
perf 3105-30 and 3093-3101; 2,220,000  
cfg, 6000A; 19,482,000 cfg

COMPLETED

