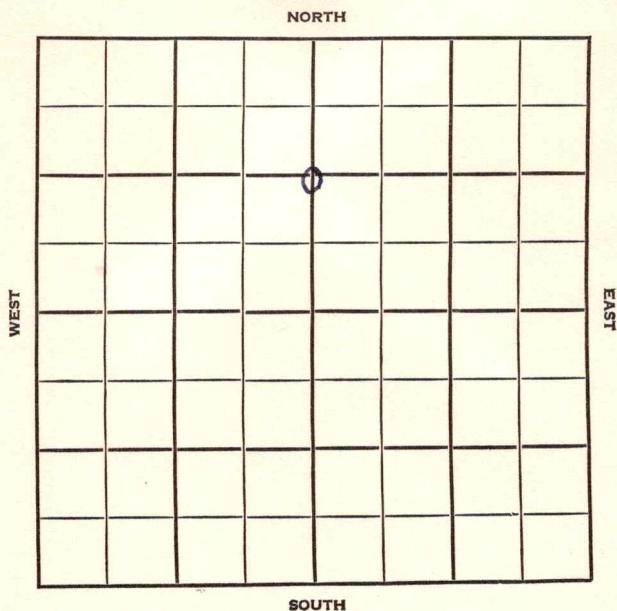


Section 25 Township 32 Range 43 WWell No. # 1 J. B. SmithCompany Texas Company


SEC.	TWP.	R.
25	32	43W

WELL NO.

1 J. B. Smith

FARM

COMPANY

Texas Co.

CONTRACTOR

Burris Drlg.

Greenwood Pool

1390


Ft. from N. Line

Ft. from S. Line

Ft. from E. Line

2640

Ft. from W. Line

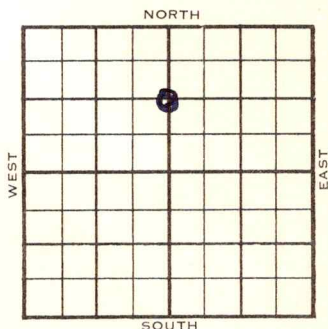

C N/2 S/2 N/2 Sec.

	ELEVATION	REPORT
1955	3568	

3/16

Spud 3-14-55
Drlg. 460'

4/13

Spud 3-14-55 Gas well TD 3289
10" @ 710 Top 2897 TD 3289
7" @ 3289 Lans 3200 CO to 3262
40/3238-48 1 BWPH 56/3212-26
381,000 CFG 1000 A 2,807,000 CFG
36 GAWPH 40/3154-64 144/3070-3106
24/3018-24 28/3006-13 24/2968-74
5000 A 8,560,000 CFG
Comp. 17,348,000 CFGPD


COMPLETED

County **Morton** State **Kansas**
 Sec. **25** (Blk.) **32** (Sur.) **43W** Map No.

Operator **Texas Company**

Well No. **1** Farm **J. B. Smith**

Elev. **3568** Location **C N $\frac{1}{2}$ S $\frac{1}{2}$ N $\frac{1}{2}$ Sec.**

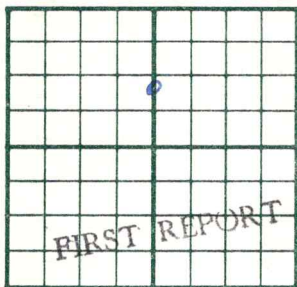

1390 Ft. From **N** Line **Sec.**

2640 Ft. From **W** Line **Quarter**

1st. Report **MAR 1 6 1955**

Completion

Remarks

Burris Drlg. -Contr.


Spudding Date **3-14-55**

Drlg. Data **Greenwood Pool**

drlg. 460

FABEN GILSTRAP

County Morton State Kansas
 Sec. 25 (Blk. 32 (Sur. 43W Map No.
 (Twp.) (Rge.)
 Operator Texas Company
 Well No. 1 Farm J. B. Smith
 Elev. 3568 Location C N $\frac{1}{2}$ S $\frac{1}{2}$ N $\frac{1}{2}$ Sec.

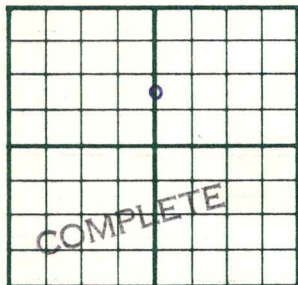

1390 Ft. From N Line Sec.
2640 Ft. From W Line Quarter
 1st. Report
 Completion APR 13 1955
 Remarks Greenwood Pool
Burris Drlg. - Contr.
 Spudding Date 3-14-55

Drlg. Data Gas well TD 3289
10" @ 710 Top. 2897 TD 3289
7" @ 3289 Lans. 3200 CO to 3262
40/ 3238-48 lbwph 56/ 3212-26
381,000 cfg 1000 A 2,807,000 cfg
36 gawph 40/ 3154-64 144/ 3070-3106
24/ 3018-24 28/ 3006-13 24/ 2968-74
5000 A 8,560,000 c fg
Comp. 17,348,000 c f g p d

FABEN GILSTRAP