


Section 33 Township 32 Range 43W

Well No. 1 Santa Fe "D"

Company Cities Service

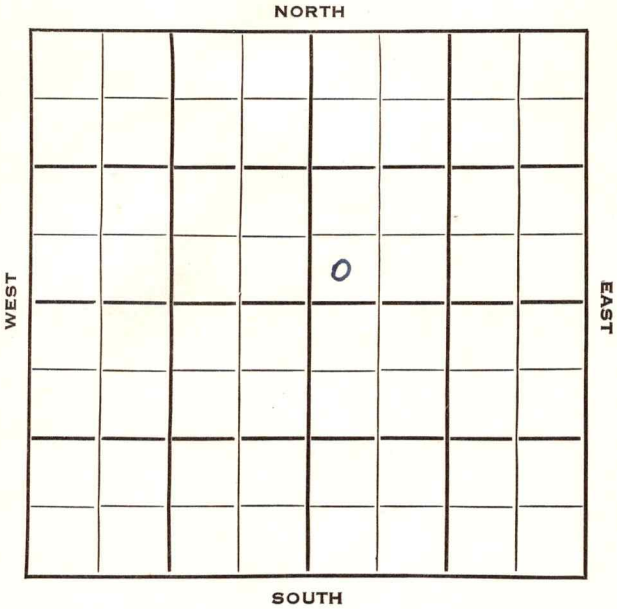

SEC.	TWP.	R.
33	32	43W ✓

WELL NO.

1 Santa Fe "D"

FARM

COMPANY

Cities Service

CONTRACTOR

Holm Drlg.

Greenwood Pool

Ft. from N. Line

330


Ft. from S. Line

Ft. from E. Line

330

Ft. from W. Line

SW SW NE

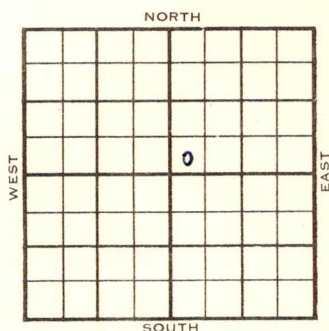

1954

ELEVATION

3615'

REPORT

4/7

Spud 4-4-54

8" @ 600'

5/12

Spud 4-4-54

Gas Well

TD 3335'

8" @ 600'

Anhy 1360', Top 2904', Lans 3175'

TD 3335'

CO to 3264'

80/ 3228'-44' 70/ 3208'-22' 20/

3198'-3203' 60/ 3180-92 2000 A

3 mcfg. 70/ 3060'-74' 40/ 3048'-56'

2000 A 4,520,000 gas

SP 3038'

40/ 3000-08 30/ 2986-92

50/ 2964-74 40/ 2948-56 100/ 2906-

26 3500 A 1,100,000 gas 1000 A

CO to 3264'

6,400,000 gas

Comp 12,100,000 gas 426#

COMPLETED

8th @ 600

J. G. McGEHEE

J. G. McGEHEE