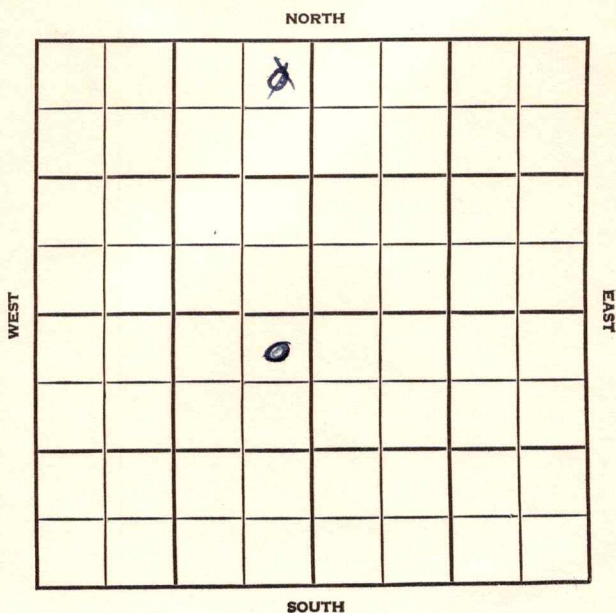


Section 16 Township 32 Range 43WWell No. 1-~~2~~ DreyerCompany Colorado O&G

SEC.	TWP.	R.
16	32	13W

WELL NO.

1-~~3~~ Dreyer

FARM

COMPANY

Colorado O&G

CONTRACTOR


Greenwood Pool

330 Ft. from N. Line

Ft. from S. Line

330 Ft. from E. Line

Ft. from W. Line

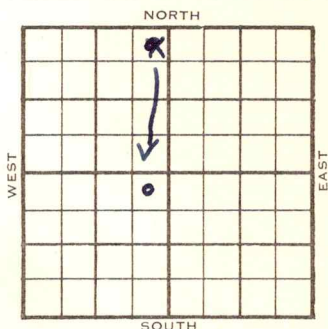NE NE ~~NW~~ ^{SW}

1954

ELEVATION

3630'

REPORT

9/1

MIR

12/15

Spud 9-1-54 Gas well TD 3390

8" @ 611 Elmont 2947 Top 3122

LeCompton 3254 TD 3390

5" @ 3388 28/3285-92 1000 A

600,000 CFG 882,000 CFG SP 3280

52/3259-72 2000 A 1,960,000 CFG

43 GWPH 1,470,000 CFG 134

13 GSWPH SP 3240 20/3206-11

16/3222-26 2000 A 623,000 CFG

4 GSWPH SP 3390 136/3120-54

1,500,000 CFG Dry 5000 A

Comp. 14,866,000 CFGPD

~~12/15~~

COMPLETED

1955

1/26

ADDITIONAL INFORMATION

PB 3110' 16/3086-90 32/3074-82

24/3058-64 4000 A 7,916,000 CFG

PB 3050' 24/3036-42 24/3016-22

28/2953-70 6000 A 7,000,000 CFG

1 BWPH PB 2920 16/2908-12 24/2848

54. 2500 A 15 GWPH Sq. perf.


CO to 2920 16/2807-11 16/2751-54

12,000 A 5 GWPH Sq. perf CO

Comp. 21,000,000 CFGPD 428# COMPLETED

FABEN GILSTRAP

County Morton State Kansas
 Sec. 16 (Blk.) 32 (Sur.) 43W Map No.
 Operator Colorado Oil & Gas
 Well No. 1 Farm Dreyer
 Elev. 3630 Location NE NE SW

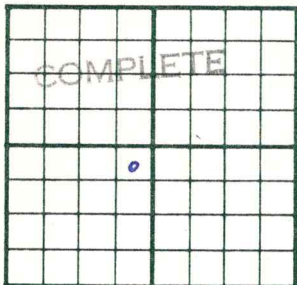

330 Ft. From N Line SW
330 Ft. From E Line Quarter
 1st. Report
 Completion DEC 15 1954
 Remarks Greenwood Pool

Spudding Date 9-1-54

Drlg. Data Gas well TD 3390
8" @ 611 Elmont 2947 Top. 3122
LeCompton 3254 TD 3390 5" @ 3388
28/ 3285-92 1000 A 600,000 cfg
882,000 cfg SP 3280 52/ 3259-72
2000 A 1,960,000 cfg 43 gwp
1,470,000 cfg 13 gswph SP 3240
20/ 3206-11 16/ 3222-26 2000 A
623,000 cfg 4 gswph SP 3390
136/ 3120-54 1,500,000 cfg dry 5000 A
Comp. 14,866,000 cfcpd

FABEN GILSTRAP


Kansas

Map No. _____ Sec. 16 Twp. 32 R. 43Well No. 1 DreyerColorado Oil & Gas Company**CORRECTION**

Contractor _____

NE NE SW

SECTION PLAT

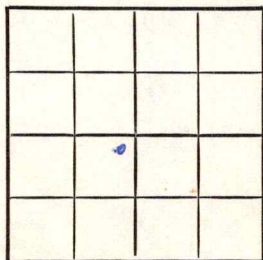330 Ft. from N. Line

_____ Ft. from S. Line

330 Ft. from E. Line

_____ Ft. from W. Line

Marton Co.

Location _____

Rig up _____

Drilling and Remarks:

Reported

NE NE NW

RECORD

Cased _____ in., _____ ft.

Sand _____

Gas _____

Oil _____

Total Depth _____

PRODUCTION

1st 24 hrs. Nat. _____

1st 24 hrs. after shot _____

Gas _____ Cu. Ft.

Dry Hole _____

Abandoned _____

Date

SEP 15 1954

FABEN GILSTRAP

Scout

1-26-55

Morton County Kansas

Colorado Oil & Gas

#1 Dreyer

NE NE SW

Completed 12-15-54

16-32-43W

ADDITIONAL INFORMATION

There are 729 sections in
Morton CO. There were 93 completions
dated 12-15-54. I could use a hint...
Serriously tho, please check.

Luville

Give Me the Sec. Twp. & Rge.

PB 3110	16/ 3086-90	32/ 3074-82	24/ 3058-64
4000 A	7,916,000 cfg	PB 3050	24/ 3036-42
24/ 3016-22	28/ 2953-70	6000 A	7,000,000 cfg
1 bwph	PB 2920	16/ 2908-12	24/ 2848-54
15 gwph	sq. perf.	CO to 2920	16/ 2807-11
16/ 2751-54	12000 A	5 gwph	sq. perf.
Comp. 21,000,000 cfgpd	428#		

on card

This was my fault. I'm sorry.

mae