


Section 22 Township 3 2 Range 43W

Well No. 1 Saunders

Company Colo. Oil & Gas & CO

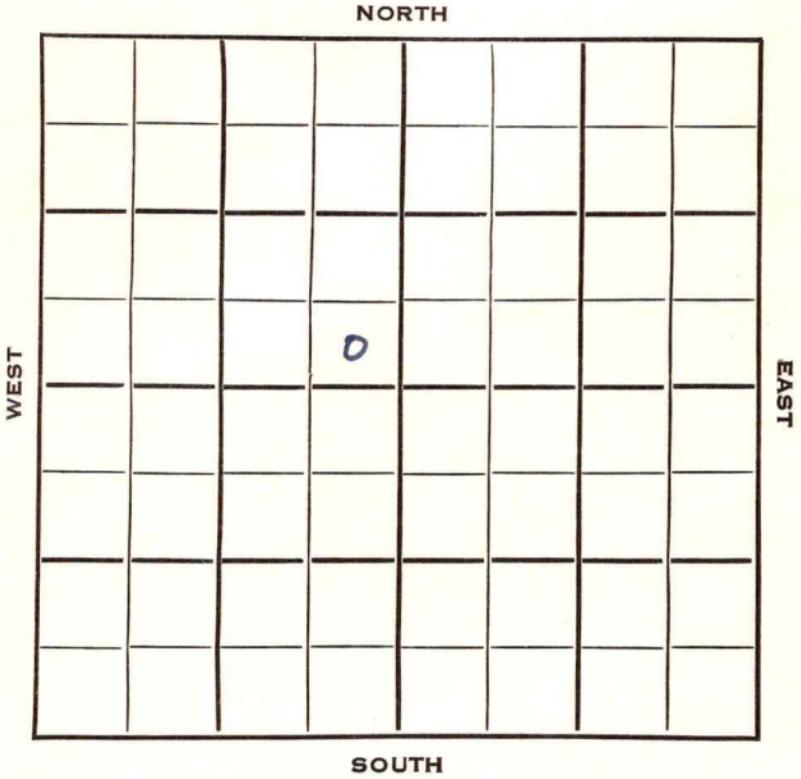


KANSAS

Morton

SEC.	TWP.	R.
22	32	43 W
WELL NO. # 1 Saunders		FARM
COMPANY Colo. Oil & Gas & CSO		
CONTRACTOR		

_____ Ft. from N. Line
 330 _____ Ft. from S. Line
 330 _____ Ft. from E. Line
 _____ Ft. from W. Line

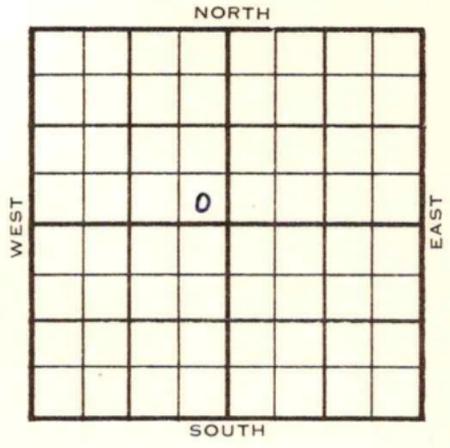

SE SE NW

	ELEVATION	REPORT
1954	3618'	
5/5	Spud 4-30-54 Drlg. 1425'	
5/12	8" @ 600' Drlg 3267'	
5/19	RTD 3406' 5" @ 3370'	
5/26		
5/26	Anhy 1408', Top 2953', Lans 3242'	
6/2	NR	
6/9	"	
9/8	Spud 4-30-54 - Gas Well TD 3406' 8"@ 600' Anhy 1408', Top 2953', Lans 3242' TD 3406' 5" @ 3370' CO to 3315, 56/3280-94, 4 bswph PB 3274, 40/3256-66, 8 gwph 1500A S/150 gfph, 15 hrs. PB 3200' 42/3154-68, 80/3108-28, 5000A 2,200,000 cfg CO to 3315' 19,500,000 cfg Comp.	

COMPLETED

County Morton State Kansas
 Sec. 22 (Blk. 32) (Sur. 43W) (Twp.) (Rge.) Map No.
 Operator Colo. Oil & Gas & CSO
 Well No. 1 Farm Saunders
 Elev. 3618 Location SE SE NW

COMPLETE

0

330 Ft. From S Line NW
330 Ft. From E Line Quarter
 1st. Report
 Completion SEP 8 1954
 Remarks

Spudding Date 4-30-54

Drlg. Data Gas well TD 3406
8" @ 600 Anhy1408 Top. 2953
Lans. 3242 TD 3406 5" @ 3370 CO to
3315 56/ 3280-94 4 bswph PB 3274
40/ 3256-66 8 gwph 1500 A S/ 150 gfph
15 hr. PB 3200 42/ 3154-68 80/ 3108-28
5000 A 2,200,000 cfg CO to 3315
19,500,000 cfg Comp.

FABEN GILSTRAP