


Section 25 Township 32 Range 43W

Well No. #1 Barkell

Company E. G. Bradley

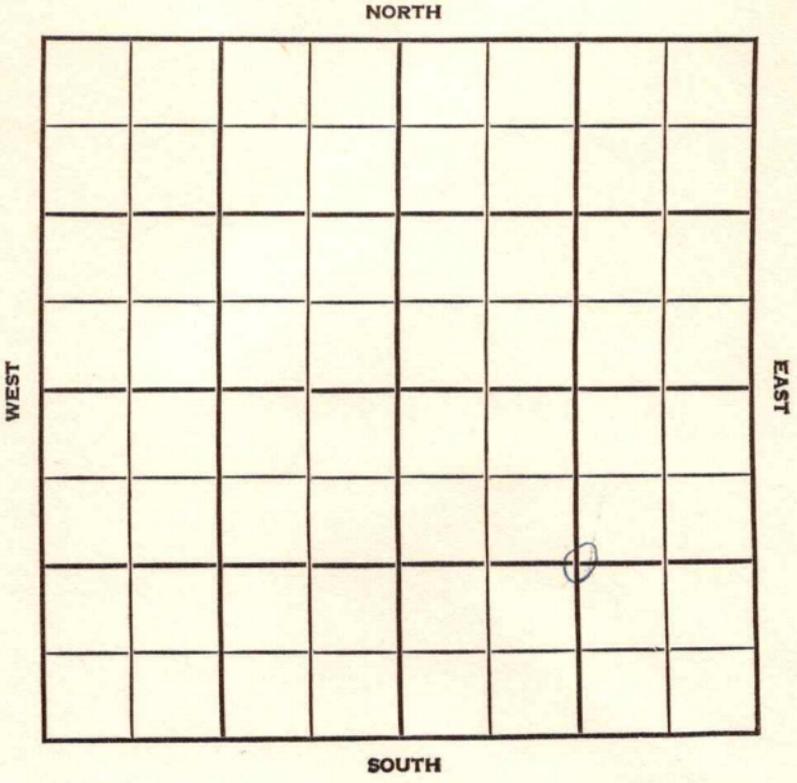

Morton

KANSAS

SEC. 25	TWP. 32	R. 43W
------------	------------	-----------

WELL NO. #1 Barkell FARM

COMPANY E.G. Bradley

CONTRACTOR Musgrove


Greenwood

_____ FT. FROM N. LINE

_____ FT. FROM S. LINE

_____ FT. FROM E. LINE

_____ FT. FROM W. LINE

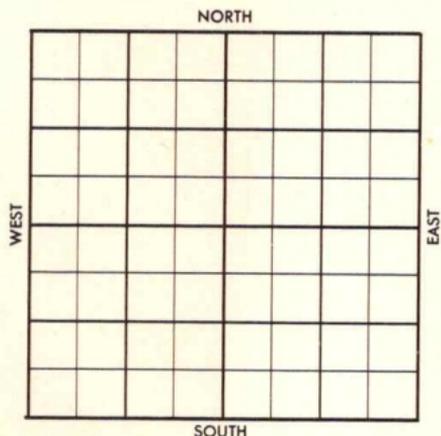

C SE $\frac{1}{4}$

Texas - FO

1956	ELEVATION 3548	REPORT
------	-------------------	--------

5-29
6-27

MIR
 Comm. 5-28-56
 8 5/8" @ 603/300
 5 1/2" @ 3201/200
 CO ? 48/3180-92, 3040-80, 32/ 2911/19
 16/2942-46, 24/2956-62, 32/2976-84
 48/2986-98, Frac no ga 72-20 25.400
 MCF RP 393
 Tops Log:
 Tp. 2911; L. 3172
 TD. 3202

COMPLETED

County Morton Elev. _____
 Sec. 25 Twp. 32 Rge. 43W
 Company E. G. Bradley
 Farm Name Barkell No. 1

TOPS	DEPTH	LOG	DATUM
Anh.			
TP			
H.			
Tr.			
Dg.			
Bl.			
L.			
K.C.			
B.K.C.			
Ce.			
C.			
M.			
M.			
K.			
Mz.			
Me.			
V.			
S.			
S.			
A.			
R.			
PE.			
G.			
T.D.			

Loc. in Sec. C SE/4
 Geol. _____
 Contr. Musgrove
 Pool Greenwood

FIRST REPORT
 MAY 29 '38

Date Comm. M I R Texas - FO

[Faint red stamp: MAY 2 1938]
[Large red handwritten mark]
[Faint red stamp: R.G.]

Co.
 Lse.
 No.
 Sec.
 T.
 R.

County Morton Elev. 3549
 Sec. 25 Twp. 32 Rge. 13W
 Company E. G. Bradley
 Farm Name Barkell No. 1

TOPS	DEPTH	LOG	DATUM	Loc. in Sec.
Anh.				C SE/4
Tp.		2911		
H.				
Tr.				
Dg.				
Bl.				
L.		3172		Geol.
K.C.				Contr.
B.K.C.				Musgrove
Ce.				Pool
C.				Greenwood
M.				<div style="border: 1px solid black; padding: 5px; text-align: center;"> COMPLETE JUN 27 '56 </div>
M.				
K.				
Mz.				
Me.				
V.				
S.				
S.				
A.				
R.				
PE.				
G.				
TD.	3202			

Date Comm. Texas - FO

MIR JUN 6 '56 5-28-56

8 1/2 603/300

5 1/2 3201/200

JUN 13 '56 JUN 20 '56 in JUN 27 '56 CO ?

48/3180-92 3040-80 22/

2911-19 16/2942-46 24/

2956-62 32/2976-84 48/2986

-98 Frac no 9a 72-20

25,400 MCF RP 393