

Section 26 Township 32 Range 43WWell No. 1 Santa Fe "E"Company CSO, Skelly & Texas

NORTH

			0				

WEST

EAST

SOUTH

Morton

KANSAS

SEC.	26	TWP.	32	R.	43W
------	----	------	----	----	-----

WELL NO.

#1 Santa Fe "E"

FARM

COMPANY

CSO, Skelly & Texas

CONTRACTOR

Holm Drlg.

Greenwood Pool

Ft. from N. Line


330

Ft. from S. Line

330

Ft. from E. Line

Ft. from W. Line

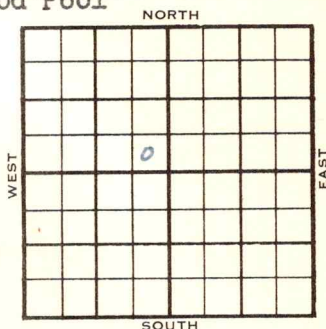

SE SE NW

1954

ELEVATION

3570'

REPORT

5/12

M I R

5/19

Drlg 2850'

5/26

Anhy 1363', Top 2902', Lans 3184',
 RTD 3350'
 5" @ 3196'

6/15

Spud 5-7-54 Gas well TD 3350

Anhy 1363 Top 2902 Lans 3184

~~TD 3350~~ TD 3350 5" @ 3196

CO to 3228 1½ MCFG 1500 A

6,400,000 gas SP 3150

50/3092-3102 120/3054-78

30/3044-50 3000 A 21,300,000 gas

SP 3035 20/3004-08 30/2992-98

35/2980-87 40/2960-68 20/2944-48

120/2904-28 4000 A 12,100,000 gas.

1000 A CO to 3150 1000 A

CO to 3228 Comp. 27,400,000 CFGPD

431#

COMPLETED

County

State

Kansas

Sec.

26

(Blk.)
(Twp.)

32

(Sur.)
(Rge.)

43W

Map No.

Operator

CSO, Skelly & Texas

Well No.

1

Farm

Santa Fe "E"

Elev.

3570

Location

SE SE NW

0

FIRST REPORT

330

Ft. From

22

Line

NW

330

Ft. From

15

Line

Quarter

1st. Report

MAY 12 1954

Completion

Remarks

Holm D.,lg. - Contr.


Spudding Date

Drlg. Data

Greenwood Pool

M I R

J. G. MCGEE

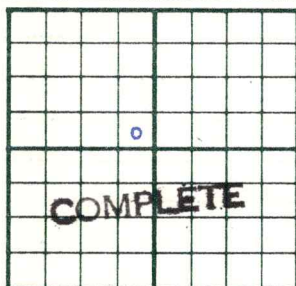County Morton State KansasSec. 26 (Blk. 32 (Sur. 4 (Twp. 3W Map No. Operator CSO, Skelly & TexasWell No. 1 Farm Santa Fe "E"Elev. 3570 Location SE SE NW330 Ft. From S Line NW330 Ft. From E Line Quarter1st. Report Completion JUN 15 1954Remarks Greenwood PoolHelm Drlg. - Contr.Spudding Date 5-7-54Drlg. Data Gas well TD 3350Anhy 1363 Top. 2902 Lens. 3184TD 3350 5" @ 3196 CO to 3228 1 1/2 mcf/g1500 A 6,400,000 gas SP 315050/ 3092-3102 120/ 3054-78 30/ 3044-503000 A 21,300,000 gas SP 303520/ 3004-08 30/ 2992-98 35/ 2980-8740/ 2960-68 20/ 2944-48 120/ 2904-284000 A 12,100,000 gas 1000 ACO to 3150 1000 A CO to 3228Comp. 27,400,000 cf/gpd 431#