

Morton

KANSAS

SEC.	TWP.	R.
27	32	43 W

WELL NO. # 1 Witcher "A" FARM

COMPANY Cities Service


CONTRACTOR Holm Drlg.

660 Ft. from N. Line

Ft. from S. Line

330 Ft. from E. Line

Ft. from W. Line

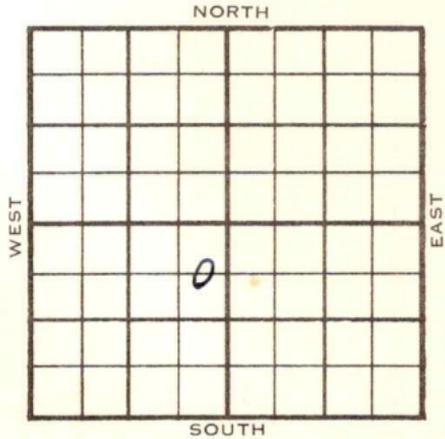

C $\frac{1}{2}$ NE SW

ELEVATION	REPORT
1954	3559'

8/25 Spud 8-20-54
8" @ 600
Drlg. 915'

10/27 Spud 8-20-54 Gas well TD 3290
8" @ 600 Anhy 1325 Top 2852
Lans. 3130 TD 3290 5" @ 3284
CO to 3266 50/3042-52 70/3014-28
40/3002-10 4,100,000 CFG 6000 A
14,000,000 CFG SP 2985 25/2952-57
40/2936-44 40/2916-24 30/2900-06
30/2872-78 40/2858-64 8000 A
16,000,000 CFG 2000 A CO to 3260
2000 A 14,000,000 CFG
Comp. 24,700,000 CFGPD

COMPLETED

County Morton State Kansas

Sec. 27 (Blk. 32 (Sur. 43W Map No. (Twp.) (Rge.))

Operator Cities Service

Well No. 1 Farm Witcher "A"

Elev. 3559 Location C E $\frac{1}{2}$ NE SW

660 Ft. From N Line SW

330 Ft. From E Line Quarter

Ist. Report

Completion OCT 27 1954

Remarks Greenwood Pool

Holm Drlg. - Contr.

Spudding Date 8-20-54

Drlg. Data Gas well TD 3290

8" @ 600 Anhy 1325 Top. 2852

Lans. 3130 TD 3290 5" @ 3284

CO to 3266 50/ 3042-52 70/ 3014-28

40/ 3002-10 4,100,000 cfg 6000 A

14,000,000 cfg SP 2985 25/ 2952-57

40/ 2936-44 40/ 2916-24 30/ 2900-06

30/ 2872-78 40/ 2858-64 8000 A

16,000,000 cfg 2000 A CO to 3260

2000 A 14,000,000 cfg

Comp. 24,700,000 cfgpd

FABEN GILSTRAP