


Morton KANSAS

DX 78-1

Section 29 Township 32 Range 43W

Well No. 1 Mohler

Company Amerada Pet

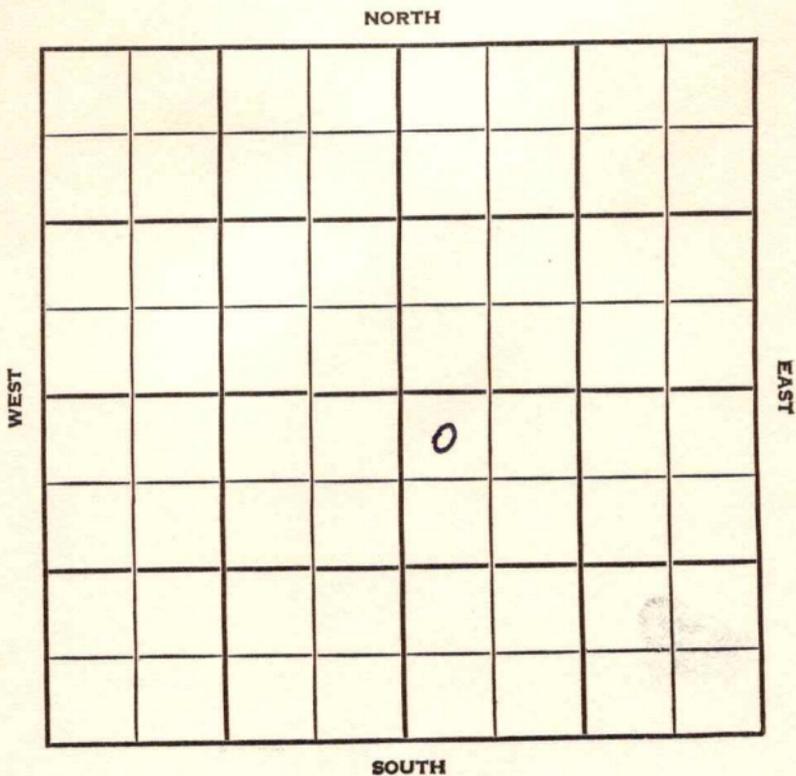

Morton KANSAS


SEC.	29	TWP.	32	R.	43W
WELL NO.	1 Mohler				FARM
COMPANY	Anderada Pet.				
CONTRACTOR					

330 _____ Ft. from N. Line

_____ Ft. from S. Line

_____ Ft. from E. Line

330 _____ Ft. from W. Line

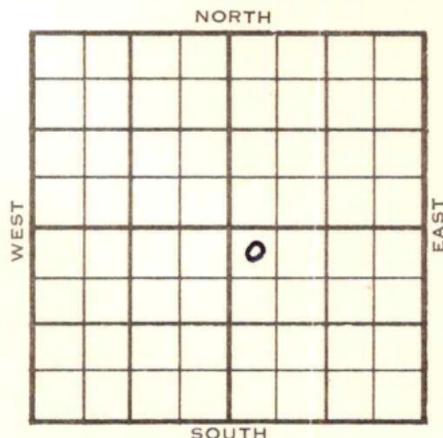

NW NW SE

	ELEVATION	REPORT
1954	3618	
7/21	Spdg 7-20-54	
	Drlg. 540	
8/4	Spdg 7-20-54	
	Gas well	
	TD 3362	
	8" @ 681	
	Neva 2560 Top 2930 Lans. 3202	
	TD 3362	
	5" @ 3358	
	CO to 3317 24/ 3244-50 20/ 3227-32	
	24/ 3204-10 2000 A S/ 3 bswph	
	6 hr. PB 3141 32/ 3112-20	
	40/3102-12 40/3092-3102 1 mcfg	
	500 A Comp. 7,685,000 cfcpd	

COMPLETED

County **Morton** State **Kansas**

Sec. **29** (Blk. Twp.) **32** (Sur. Rge.) **43W** Map No.

Operator **Amerada Pet.**

Well No. **1** Farm **Mohler**

Elev. _____ Location **NW NW SE**

FIRST REPORT

0

330 Ft. From **N** Line **SE**

330 Ft. From **W** Line Quarter

1st. Report **JUL 21 1954**

Completion _____

Remarks _____

Spudding Date **7-20-54**

Drlg. Data _____

drlg. 540