

Morton


KANSAS

SECTION 31 TOWNSHIP 32 RANGE 43W

WELL NO. #1-A Addington

COMPANY Cities Service

NORTH

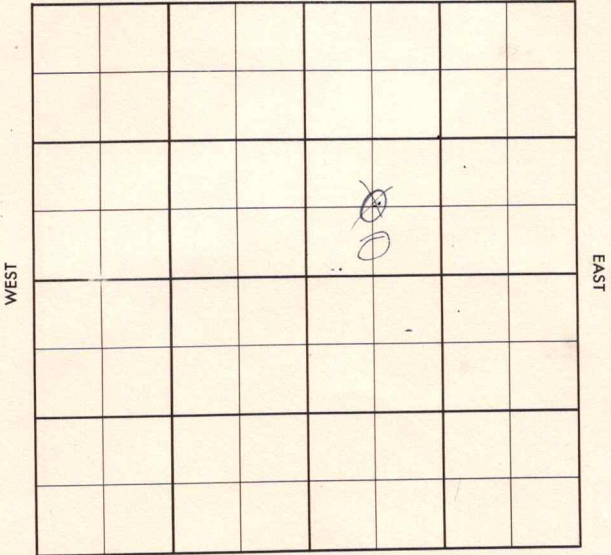

SOUTH

County Morton Elev. _____
Sec. 31 Twp. 32 Rge. 43W
Company Cities Service
Farm Name Addington No. 1-A

TOPS	DEPTH	LOG	DATUM	Loc. in Sec.
Anh.				C SW NE
Tp.				
H.				
Tr.				
Dg.				
Bl.				
L.				Geol. _____
K.C.				Contr. _____
B.K.C.				Holm Drlg.
Ce.				
C.				Pool
M.				
M.				
K.				
Mz.				
Me.				
V.				
S.				
S.				
A				
R.				
Pe.				
G.				
T.D.				

FIRST REPORT

DEC 12 '56

Date Comm. _____
Location _____

34

CORRECTION

Co.

County Morton Elev. 3629
 Sec. 31 Twp. 32 Rge. L3W
 Company Cities Service
 Farm Name Addington "A" No. 1-#

TOPS	DEPTH	LOG	DATUM	Loc. in Sec.
Anh.				G SW NE S2
T.P.	2916			
H.				
Tr.				
Dg.				
BL.				
L.				Geol.
K.C.				Contr.
B.K.C.				Holm Drlg.
Ce.				
C.				Pool
M.				
M.				
K.				
Mz.				
Mo.				
V.				
S.				
S.				
A.				
R.				
Pe.				
G.				
TD	3150			

JAN 23 '57
 0
 COMPLETE

Use.

No.

Sec.

T.

R.

Date Comm.

Location DEC 19 '56 12-14-56 85/8

600/400 Lost circ @ 1112 TD

DEC 26 '56 ✓ JAN 2 '57 SKID 330' N E

660' E of cen of sec

JAN 9 '57 3pd 12-26-58 85/8 1396

1500 5'20 3139/250

CO 3112 72/3056-76 12 12m BD

8,150 MCFC 28/3011-18 32/2996

3004 44/2974-85 28/2958-65

④ 2 hr BD. 15,800 MCFG S.I.

24 hr ~~ex~~ 5" ga IP. 300

MCFG JAN 23 '57 20" ~~ex~~ F/W 15,800

MCFG SIP 365#